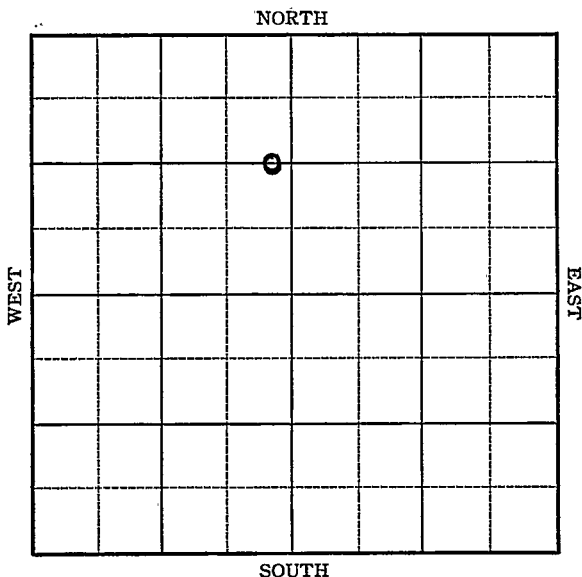
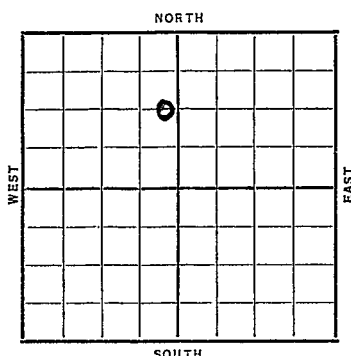


Section 20 Township 31 Range 38-WWell No. 1 SpikesCompany Panhandle Eastern

Sec. 20 Twp. 31 R. 38-WWell No. #1 Spikes Farm
Panhandle Eastern Company1320 Ft. from N. Line Ft. from S. Line200 Ft. from E. Line Ft. from W. LineElev. 3167'.

Date

REPORT

1937

12/29

R U R

1938

1/7

10" @ 549'. 7" @ 2396'.

T.D. 2399'. RUST.

1/14

Gas 2412'. Inc. 2414-31'.

to 11 M. Drlg. 2485'.

1/19

7" @ 2396'.

Sand ?

T.D. 2655'.

11 $\frac{1}{4}$ M gas.

COMPLETED

Stevens KANSAS

Map No. NM Sec. 20 Twp. 31 R. 38WWell No. 1 SpikesPanhandle Eastern Company

Contractor

FIRST REPORT

C E L NW

1320 Ft. from N. Line Ft. from S. Line200 Ft. from E. Line Ft. from W. Line

SECTION PLAT

	0		

Location Rig up

Drilling and Remarks:

RUR

RECORD

Cased in., ft.Sand Gas Oil Total Depth

PRODUCTION

1st 24 hrs. Nat. 1st 24 hrs. after shot Gas Cu. Ft.Dry Hole Abandoned

Date

DEC 29 1937 19 H. D. Hatfield Scout


Stevens

KANSASMap No. NA Sec. 20 Twp. 31 R. 38WWell No. 1 SpikesPanhandle Eastern Company

Contractor

COMPLETED

C E L NW

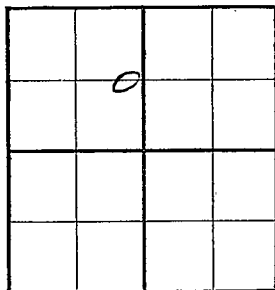1320 Ft. from N. Line Ft. from S. Line200 Ft. from E. Line Ft. from W. Line**SECTION PLAT**Location Rig up

Drilling and Remarks:

RECORDCased 7 in., 2396 ft.Sand Gas Oil Total Depth 2655**PRODUCTION**1st 24 hrs. Nat. 1st 24 hrs. after shot Gas Cu. Ft.Dry Hole Abandoned

Date

JAN 19 1938H. D. Hatfield Scout