


DX 78-1 Seward

KANSAS

Section 20 Township 31 Range 34W

Well No. I. Murphy "A"

Company Northern Nat. Gas. Prod.

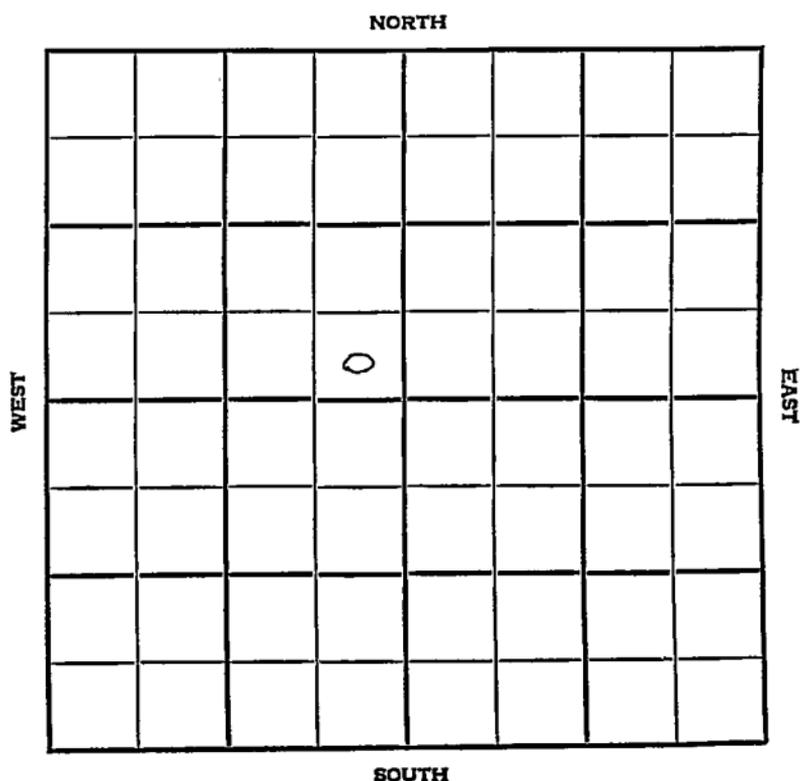



COMPLETED

County Seward Elev. 2806Sec. 20 Twp. 31 Rge. 34WCompany Northern NaturalFarm Name Murphy "A" No. 1

TOPS	DEPTH	DATUM
Cim. Anhydrite		
Ft. Riley <u>Holl.</u>	<u>2372</u>	
Howard <u>Harr.</u>	<u>2424</u>	
Topeka <u>U.Kr.</u>	<u>2450</u>	
Heebner Sh. <u>L.Kr.</u>	<u>2476</u>	
Toronto Ls.		
Brown Lime <u>Odell</u>	<u>2512</u>	
Lansing <u>Win</u>	<u>2524</u>	
Kans. City <u>Gage</u>	<u>2548</u>	
B. K. C. <u>H. &amp; Riley</u>	<u>2570</u>	
Congl.		
Miss.		
Kinderhook		
Misener		
Hunton		
Sylv. Maquo		
Viola		
Simpson		
Smp.		
Garham		
Arbuckle		
Basal Sand		
Pre. Cam.		
T. D.	<u>2602</u>	


Loc. in Section

SE SE NW

100' NW of C

Drig. Contr.

Pool

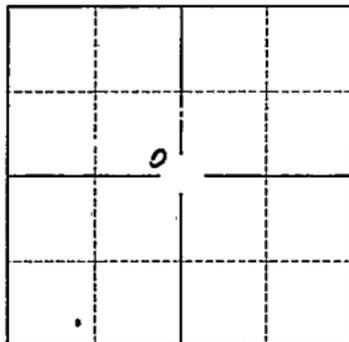

Date Comm.

Date Comp. MAY 25 '55

Spud 4-19-55 10" @ 446 TD 2540

7" @ 2436 3000 A frac 2000 A

1,576,000' cfrg DD 2602 1,600 mcf<sub>g</sub>5 $\frac{1}{2}$ " @ 2603 6000 AComp. 12,842 mcf<sub>g</sub>pd

Co.

Lse.

No.

S

T

R