


Seward

KANSAS

Section 20 Township 31S Range 33W

Well No. #1 Saley

Company Terminal Cities Service

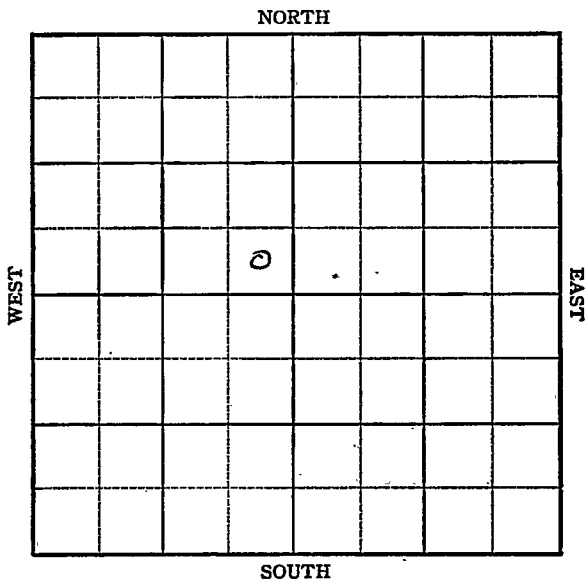

Seward KANSAS

Sec. 20 Twp. 31 R. 33W /

Well No. #1 Saley Farm
~~Cities Service~~ *Terminal*
Service Company

Hugoton Pool


 Ft. from N. Line

330' Ft. from S. Line

330' Ft. from E. Line

 Ft. from W. Line

SE NW

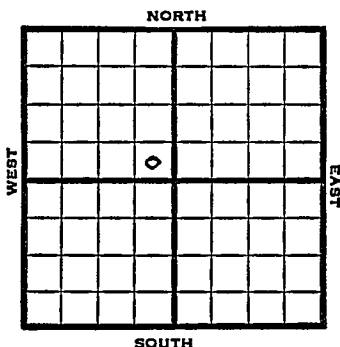

1949

Elev 2898'

R E P O R T

9/14

8" @ 670'
TD 2710'

9/21

5" @ 2709'
300 shots 2592-2693

9/28

25000 acid

10/5

"

10/12

"

10/19

TD 2710'
5" @ 2709'
Perf
25000 acid
11,300,000 Gas
408# R Pr.
Comp

COMPLETED

Map No. _____ Sec. 20 Twp. 31 R. 33W

Well No. 1 Saley

Cities Service


Company

Lohman & Johnson

Contractor

SE NW

SECTION PLAT

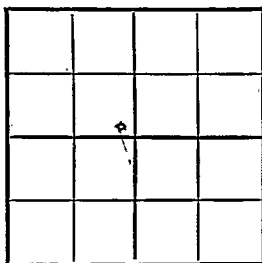

_____ Ft. from N. Line

330 Ft. from S. Line

330 Ft. from E. Line

_____ Ft. from W. Line

Seward County

RECORD

Location _____

Cased _____ in., _____ ft.

Rig up _____

Sand _____

Drilling and Remarks:

Gas _____

Oil _____

8" @ 670

Total Depth _____

. 2710 TD

PRODUCTION

1st 24 hrs. Nat. _____

1st 24 hrs. after shot _____

Gas _____ Cu. Ft.

Dry Hole _____

Abandoned _____

Date

SEP 14 1949

19

S. J. LEWIS

Scout

Map No. _____ Sec. 20 Twp. 31 R. 33W

Well No. 1 Saley _____

Terminal Service _____ Company

CORRECTION _____ Contractor

SE NE


SECTION PLAT

_____ Ft. from N. Line

330 _____ Ft. from S. Line

330 _____ Ft. from E. Line

_____ Ft. from W. Line

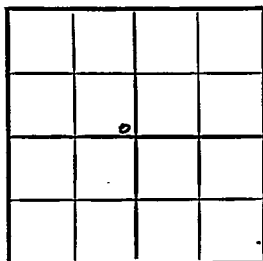

Seward County

Location _____

Rig up _____

Drilling and Remarks:

Was Cities Service _____

RECORD

Cased _____ in., _____ ft.

Sand _____

Gas _____

Oil _____

Total Depth _____

PRODUCTION

1st 24 hrs. Nat. _____

1st 24 hrs. after shot _____

Gas _____ Cu. Ft.

Dry Hole _____

Abandoned _____

Date

SEP 28 1949

19

S. J. LEWIS

Scout

Map No. _____ Sec. 20 Twp. 31 R. 33W

Well No. 1 Saley

Terminal Service _____ Company _____

COMPLETE

Contractor _____

SE NW

E. 1.2878
SECTION PLAT

_____ Ft. from N. Line

330 Ft. from S. Line

330 Ft. from E. Line

_____ Ft. from W. Line

Seward County

Location _____

Rig up _____

Drilling and Remarks:

5' @ 2705

Perf.

25000 barrel

11,300,000 Gas

408 R/L

RECORD

Cased _____ in., _____ ft.

Sand _____

Gas _____

Oil _____

Total Depth 2710

PRODUCTION

1st 24 hrs. Nat. _____

1st 24 hrs. after shot _____

Gas _____ Cu. Ft.

Dry Hole _____

Abandoned _____

Date

OCT 19 1949

S. J. LEWIS Scout