


Section 20 Township 31 Range 1W

Well No. #1 Manahan

Company Stelbar

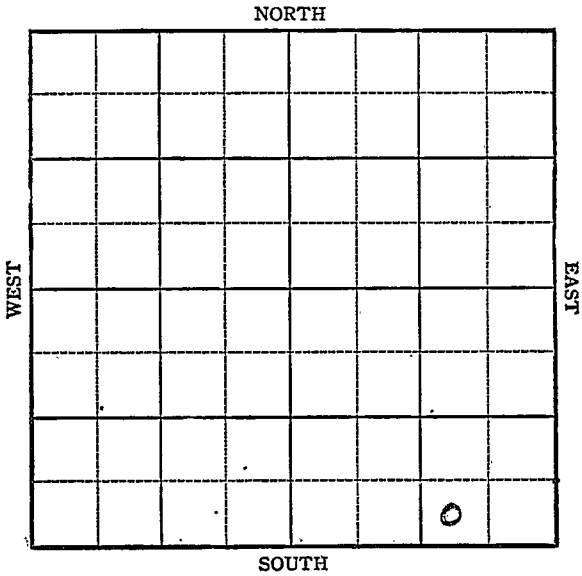

Sec. 20 Twp. 31 R. 1W

Well No. #1 Manahan Farm

Stelbar Company


Wellington

         Ft. from N. Line

330 Ft. from S. Line

990 Ft. from E. Line

         Ft. from W. Line

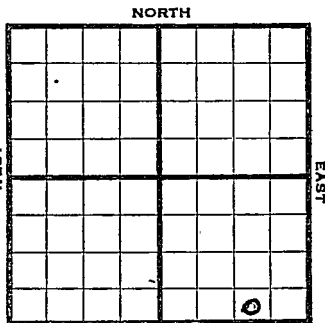

SW SE SE *Elev 1279* SOUTH

1945

R E P O R T

2/7 RUR

2/14 10" @ 346  
Drlg 1775

2/21 Drlg 2800

2/28 Miss 3686  
TD 3686  
5" @ 3686 RUST

3/7 " " "

3/14 Miss 3686  
5" @ 3686  
5000 acid  
TD 3713  
Pump 30 Pot.  
Grav. 39.0

**COMPLETED**



