
Harper

KANSAS

SECTION 20 TOWNSHIP 31 RANGE 6W

WELL NO. #4 A.C. Gish

COMPANY Skelly Oil Co.

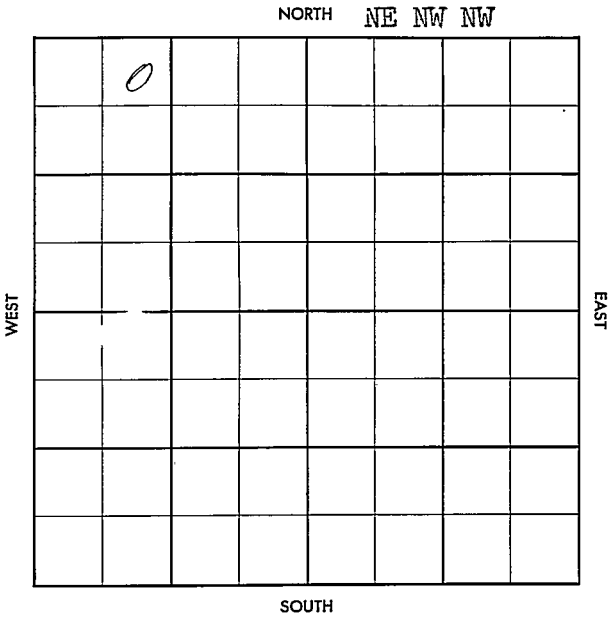

FORM 504-3 SUNRAY

FORM 513 SUNRAY

County Harper Elev.

Sec. 20 Twp. 31 Rge. 6W

Company Skelly Oil Co.

Farm Name A. C. Gish No. 4

TOPS	DEPTH	LOG	DATUM
Anh.			
Tp.			
H.			
Tr.			
Dg.			
Bl.			
L.			
K.C.			
B.K.C.			
Ce.			
C.			
M.			
M.			
K.			
Mz.			
Mg.			
V.			
S.			
S.			
A			
R.			
P€.			
G.			
T.D.			

Loc. in Sec. NE NW NW

Geol.

Contr. Hulme Drlg.

Pool Gish

MAY 20 57

FIRST REPORT

Date Comm.

Location

Co. Lse. No. Sec. T. R.

FORM 513 SUNRA

County Harper Elev. 1512

Sec. 20 Twp. 31 Rge. 6W

Company Skelly Oil Co.

FarmName A. C. Gish No. 4

TOPS	DEPTH	LOG	DATUM
Anh.			
Tp.			
H.			
Tr.			
Dg.			
Bl.			
L.			
K.C.	3758		
B.K.C. Marm	4054		
Ce.			
C.			
M. LI	4328		
M.			
K. SH	4586		
Mz.			
Mo.			
V.			
S. Sd	4713		
S.			
A			
R.			
P€.			
G.			
T.D.	4770		

Loc. in Sec. NE NW NW

Geol.

Contr. Hulme Drlg.

Pool Gish

MAY 15 '57

COMPLETE

Co. Lse. No. Sec. T. R.

Date Comm.

Location MAR 27 '57 M 12 A 3-26-57 85/8 629/1300 D 1540 APR 10 '57 P 3505 M. 17 '57 DST 4342-68 1hr 6/4" ga 100 MCFG nw 60' GCM + 180' OSGCM + 175' Mdy oil + 5' SW BHP 1578/20" DST 4370-85 1hr 6/10" ga 75 MCF nw 60' GCM + 60' HOSGCM + 60' VHOSGCM + 180' Mdy oil

FORM 513-1 SUNRAY

+110' SMCO +10' SW FP
53-191 BHP 1657/20"
DST 4387-4411 1hr rec 720'
MSW FP 55-412 BHP 1605
/20" TD 4425 APR 24 '57 5½ 4770/200
MAY 1 '57 CO 4741 30/4714-19
& 4 BOPH 3 hrs no/w
Frac MAY 8 '57 Flw 76 BO no/w
4 hrs 28/64" ch GPO
TP 230# F/w 118 BO
no/w 6 hrs 30/64" ch + 250
MCFG FTP 175 FCP 0
MAY 15 '57 F/wd 286 BO in 17 hrs
28/64" ch no/w BH BOMS
1041 BO 24 hrs no/w tr
FTP 135# FCP 475#

20-31-6 W

NE NW NW