

Harper

KANSAS

20


31S

6W

SECTION _____ TOWNSHIP _____ RANGE _____

WELL NO. #12 Gish

COMPANY Skelly Oil Co.

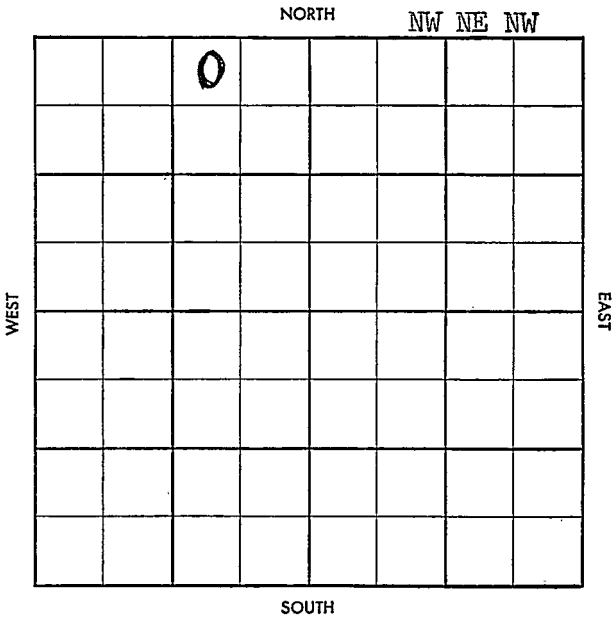


CO. Harper ELEV. _____
 SEC. 20 TWP. 31 RGE. 6W
 COMPANY Skelly Oil Co. NO. 12

0		
FIRST REPORT		
NOV 20 1957		

FARM Gish
 LOC. NW NE NW

GEOL. _____
 CONTR. Wentworth tools
 POOL Gish
 SPUD 11/15/57
8" @ 625 w/325, Drlg.
300

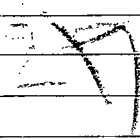

CO. _____
 LSE. _____
 NO. _____
 SEC. _____
 TWP. _____
 RGE. _____

