

DX 78-1

Harper

KANSAS

Section 20 Township 31 Range 8 W

Well No. # 1 John C. Burgess

Company Magnolia Pet.

NORTH

						0	

WEST

EAST

SOUTH

Harper KANSAS

SEC.	TWP.	R.
20	31	8W

WELL NO. _____
 COMPANY 1 John C. Burgess FARM

CONTRACTOR Magnolia Petr.


Noble Drlg.

E. Grabs Pool
 330 _____ Ft. from N. Line

_____ Ft. from S. Line

990 _____ Ft. from E. Line

_____ Ft. from W. Line

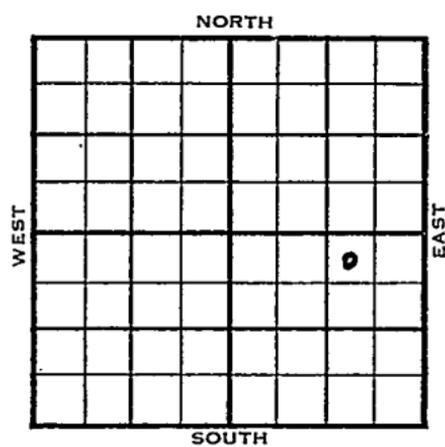

NW NE SE

1955	ELEVATION	REPORT
------	-----------	--------

2/2
 3/9

Location

Spud 2-8-55 Oil well TD 4450
 9-5/8" @ 209 Miss 4379
 DST 4378-87 open 1 hr rec 60' Drlg.
 mud, 200# DST 4380-92 open 1 hr,
 rec 60' HOCM, 70' OCM, 50' SW
 1105# TD 4450 5" @ 4449 GO to 4411
 48/4380-88 B/27 GOPH 10 GSWPH 12 hr.
 frac. 5000 A S/35 BO 15 BSW 10 hr.
 P/94 BO 23 BSW Comp. 81 BOPD
 35 BSW
 LOG TOPS: Heeb 3377, Tor 3411',
 Doug 3440', Lans 3619', KC 3872',
 Miss 4378'

COMPLETED

County Harper State Kansas
 Sec. 20 (Blk. 31) (Sur. 8W) (Twp.) (Rge.) Map No.
 Operator Magnolia Pet.
 Well No. 1 Farm John C. Burgess
 Elev. Location NW NE SE

330 Ft. From N Line SE
990 Ft. From E Line Quarter
 Ist. Report
 Completion MAR 9 1955
 Remarks E. Grabs Pool
Noble Drlg. - Contr.
 Spudding Date 2-8-55

Drlg. Data Oil well TD 4450

9 5/8" @ 209 Miss. 4379 DST 4378-87
open 1 hr. Rec. 60' drlg. mud 200#
DST 4380-92 open 1 hr. Rec. 60' hocm
70' ocm 50' sw 1105# TD 4450
5" @ 4449 CO to 4411 48/ 4380-88
B/ 27 goph 10 gswph 12 hr. frac
5000 A S/ 35 bo 15 bsw 10 hr.
P/ 94 bo 23 bsw Comp. 81 bopd 35 bsw

LOG TOPS:
Heeb. 3377 Tor. 3411 Doug. 3440
Lans. 3619 KC 3872 Miss. 4378

FABEN GILSTRAP