
DX 78-1

Harper KANSAS

Section 20 Township 31 Range 8W

Well No. 1 Bear

Company Woodriver Oil

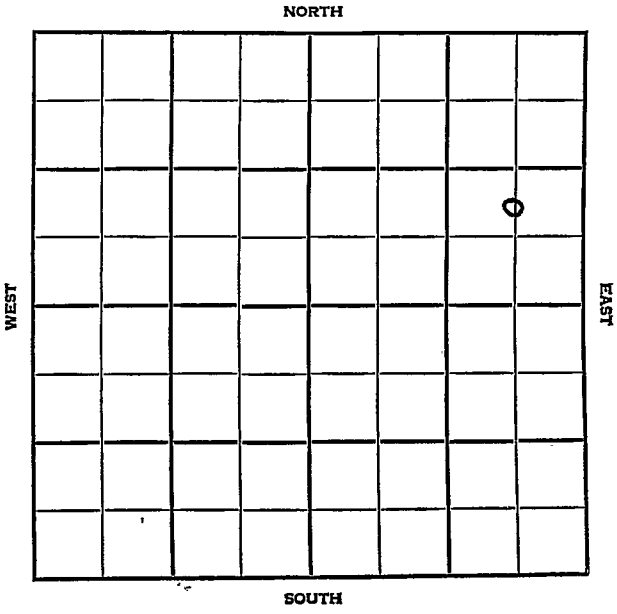

Harper KANSAS

SEC.	TWP.	R.
20	31	8W

WELL NO. -

#1 Bear FARM

COMPANY

Woodriver Oil

CONTRACTOR

Wakefield.

Burgess Pool


_____ Ft. from N. Line

990 Ft. from S. Line

660 Ft. from E. Line

_____ Ft. from W. Line

C N½ SE NE

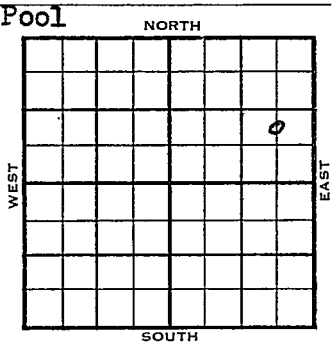

1955	ELEVATION 1579' REPORT
2/16	Spud 2-13-55 8" @ 223' WOC
3/30	Spud 2-13-55 Oil well TD 4380 8" @ 223 Top. 3259 Heeb 3379 Tor. 3400 Doug 3469 Lans 3625 KC 3884 Miss. 4372 DST 4372-80 open 1 hr rec 285' oil 5' wtr. 1270# TD 4380 5" @ 4375 Co to 4380 S/3 BOPH sd-oilpfrac. F/25 BOPH 3 hr. F/30 BOPH 4 Hr. Comp. F/554 BOPD COMPLETED

DX-78

FORM 275 FOR SALE BY KANSAS BLUE PRINT CO.

County Harper State Kansas

Sec. 20 (Blk. Twp.) 31 (Sur. Rge.) 8W Map No.

Operator Woodriver Oil

Well No. 1 Farm Bear

Elev. Location C N½ SE NE



990 Ft. From S Line NE

660 Ft. From E Line Quarter

1st. Report FEB 16 1955

Completion

Remarks Wakefield - Contr.

Spudding Date 2-13-55

Drlg. Data Burgess Pool

8" @ 223 WOC

FABEN GILSTRAP

FORM 275 FOR SALE BY KANSAS BLUE PRINT CO.


County Harper State Kansas

Sec. 20 (Blk. Twp.) 31 (Sur. Rge.) 8W Map No.

Operator Woodriver Oil

Well No. 1 Farm Bear

Elev. 1579 Location C N½ SE NE

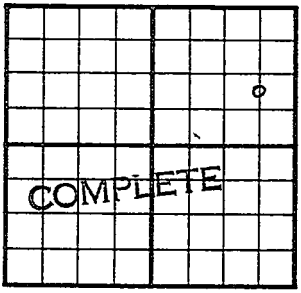

990 Ft. From S Line NE

660 Ft. From E Line Quarter

1st. Report

Completion MAR 3 0 1955

Remarks Burgess Pool
Wakefield - Contr.

Spudding Date 2-13-55

Drlg. Data Oil well TD 4380

8" @ 223 Top. 3259 Heeb. 3379

Tor. 3400 Doug. 3469 Lans. 3625

KC 3884 Miss. 4372 DST 4372-80

open 1 hr. Rec. 285' oil 5' wtr.

1270# TD 4380 5" @ 4375 CO to 4380

S/ 3 boph sd-oil-frac F/ 25 boph 3 hr.

F/ 30 boph 4 hr. Comp. F/ 554 bopd

FABEN GILSTRAP