

15-025-20316

KANSAS

State Geological Survey
WICHITA BRANCH

WELL COMPLETION REPORT AND
DRILLER'S LOG

S. 17 T. 31 R. 21 E
Loc. 2130' FNL & 660' FWL SW NW
County Clark

API No. 15 — 025 — 20,316
County Number

Operator
Mesa Petroleum Company

Address
50 Penn Place, Suite 1200 Okla City, Okla 73118


Well No. #1-17 Lease Name Schieb

Footage Location
2130 feet from (N) (X) line 660 feet from (X) (W) line

Principal Contractor Search Drilling Co. Geologist Claude Sheats

Spud Date 8-13-79 Date Completed 8-25-79 Total Depth 5380

Directional Deviation Oil and/or Gas Purchaser

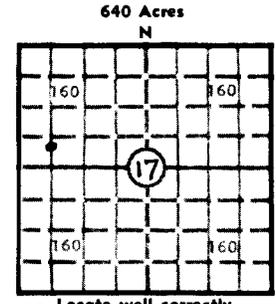

Locate well correctly
Elev.: Gr. 2178
DF 2185 KB 2188

CONFIDENTIAL

CASING RECORD

Report of all strings set — surface, intermediate, production, etc.

Purpose of string	Size hole drilled	Size casing set (in O.D.)	Weight lbs/ft.	Setting depth	Type cement	Sacks	Type and percent additives
Surface	12 1/4	8 5/8	24	633	Poz	450	2% CaCl

LINER RECORD

PERFORATION RECORD

Top, ft.	Bottom, ft.	Sacks cement	Shots per ft.	Size & type	Depth interval

Size	Setting depth	Packer set at

ACID, FRACTURE, SHOT, CEMENT SQUEEZE RECORD

Amount and kind of material used	Depth interval treated

INITIAL PRODUCTION

Date of first production		Producing method (flowing, pumping, gas lift, etc.)			
RATE OF PRODUCTION PER 24 HOURS	Oil	Gas	Water	Gas-oil ratio	
	bbls.	MCF	bbls.	CFPB	
Disposition of gas (vented, used on lease or sold)			Producing interval (s)		

INSTRUCTIONS: As provided in KCC Rule 82-2-125, within 90 days after completion of a well, one completed copy of this Drillers Log shall be transmitted to the State Geological Survey of Kansas, 4150 Monroe Street, Wichita, Kansas 67209. Copies of this form are available from the Conservation Division, State Corporation Commission, 245 No. Water, Wichita, Kansas 67202. Phone AC 316-522-2206. If confidential custody is desired, please note Rule 82-2-125. Drillers Logs will be on open file in the Oil and Gas Division, State Geological Survey of Kansas, Lawrence, Kansas 66044.

Operator Mesa Petroleum Co.		DESIGNATE TYPE OF COMP.: OIL, GAS, DRY HOLE, SWDW, ETC.: Dry Hole
Well No. 1-17	Lease Name Schieb	
S 17 T 31S R 21 ^K _W		Clark Co., KS

WELL LOG	SHOW GEOLOGICAL MARKERS, LOGS RUN, OR OTHER DESCRIPTIVE INFORMATION.
Show all important zones of porosity and contents thereof; cored intervals, and all drill-stem tests, including depth interval tested, cushion used, time tool open, flowing and shut-in pressures, and recoveries.	

FORMATION DESCRIPTION, CONTENTS, ETC.	TOP	BOTTOM	NAME	DEPTH
DST #1 5234-5260 30", 60", 60", 120" IH, FH: 2540, 2520 IF, FF: 53-53, 53-53 ISI, FSI: 1262, 711 Rec. 15' SOCM			Toronto Lansing Cherokee Morrow Miss.	4312 4504 5097 5205 5229
DST #2 5091-5236 30", 60", 60", 120" IH, FH: 2509, 2519 IF, FF: 30-30, 41-41 ISI, FSI: 61, 51 Rec. 20' DM				

USE ADDITIONAL SHEETS, IF NECESSARY, TO COMPLETE WELL RECORD.

Date Received	<p style="text-align: center;"><i>C. Brad Couch</i> Signature</p> <p style="text-align: center;">Staff Engineer Title</p> <p style="text-align: center;">September 13, 1979 Date</p>
---------------	--

17-31S-21W

Brad

DRILLERS LOG

SCHIEB 1-17

CASING RECORD:
8 5/8" set at 633'
w/ 450 sacks cement

OPERATOR: Mesa Petroleum Company

DESCRIPTION

660' FWL & 2310 FNL,
Section 17-31S-21W
Clark County,
Kansas

TOTAL DEPTH
5380'

CONTRACTOR: Search Drilling Company

COMMENCED: August 13, 1979

COMPLETED: August 28, 1979

COMPLETED

<u>FORMATION</u>	<u>FROM</u>	<u>TO</u>	<u>REMARKS</u>
Red Bed	0	633	
Red Bed	633	1395	
Red Bed & Shale	1395	1995	
Red Bed, Lime and Shale	1995	2235	
Lime and Shale	2235	5260	
Lime and Shale, Mississippi	5260	5372	
Mississippi	5372	5380	
Rotary Total Depth	5380		D & A

I certify that this is a true and correct copy of the above log to the best of my knowledge.

SEARCH DRILLING COMPANY

W. G. Dressen
W. G. Dressen

Subscribed and sworn to before me this 29th day of August, 1979.

My commission expires:
February 22, 1981

Maxine Dressen
Maxine Dressen

