


SECTION 21 TOWNSHIP 31S RANGE 12W

WELL NO. #1 Elliott "A"

COMPANY Aylward Drlg.

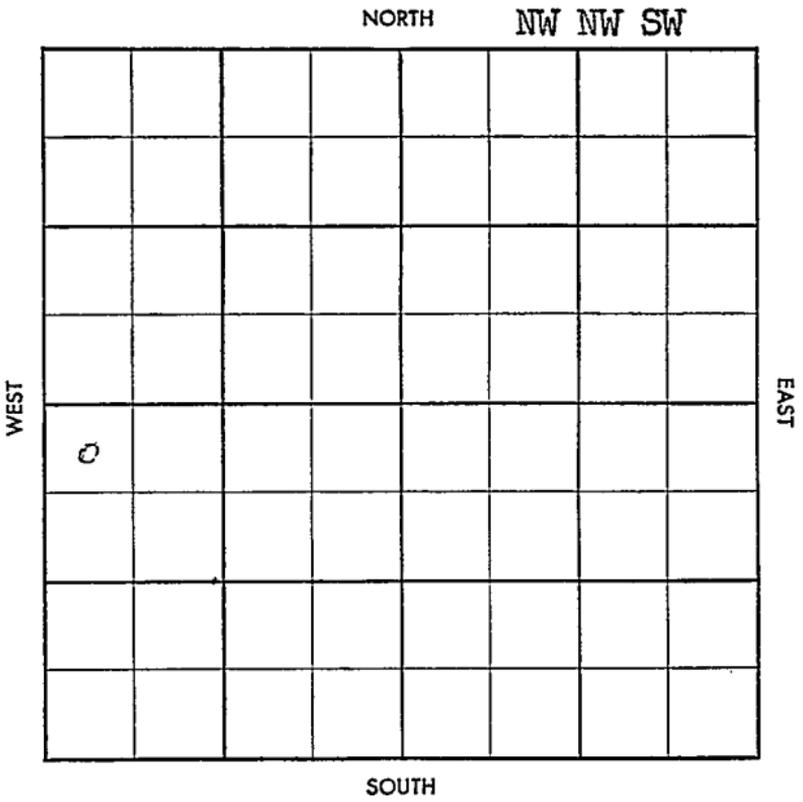

Twp. X Pool X

Co. X Facet 28

# WILDCAT

5-513-B

County Barber Elev. \_\_\_\_\_  
 Sec. 21 Twp. 31 Rge. 12W  
 Company Aylward Drlg.  
 Farm Name Elliott "A" No. 1

TOPS	DEPTH	LOG	DATUM
Anh.			
Tp.			
H.			
Tr.			
Dg.			
B.L.			
L.			
K.C.			
B.K.C.			
Ce.			
C.			
M.			
M.			
K.			
Mz.			
Mq.			
V.			
S.			
S.			
A.			
R.			
Pf.			
G.			
T.D.			

Loc. in Sec. NW NW SW  
 Geol. \_\_\_\_\_  
 Contr. \_\_\_\_\_  
 Co. Tools # 2  
 Pool \_\_\_\_\_  
 Wildcat

JUN 11 1958  
**FIRST REPORT**

Date Comm. Gulf & Texas - DHM  
 Location ETD 4300

Co.

sec.

T.

R.

~~Twp~~ Pool ~~X~~  
~~Co~~ ~~X~~

County Barber Elev Well of 1614 RB  
 Sec. 21 Twp. 31 Rge. 12W  
 Company Aylward Drlg.  
 Farm Name Elliott "A" No. 1

TOPS	DEPTH	LOG	DATUM
Anh.			
Tp.			
H.	<u>3555</u>		
Tr.			
Dg. <u>sd</u>	<u>360.6</u>	<u>3623</u>	
B.L.			
L.	<u>3750</u>	<u>3753</u>	
K.C.			
B.K.C.			
Ce.			
C.			
M.	<u>4264</u>	<u>4258</u>	
M.			
K.			
Mz.			
Mq.			
V.			
S.			
S.			
A.			
R.			
Pf.			
G.			
T.D.	<u>4326</u>		

Loc. in Sec. NW 1/4 SW

Geol. \_\_\_\_\_  
 Contr. \_\_\_\_\_  
 Co. tools #2

Pool Wildcat

**ABANDONED**  
 JUN 25 '58

Date Comm. 6-12-58 Gulf & Texas - LHW  
 Location ETD 4300 JUN 18 '58 8" 215/140  
Ø 3175 JUN 25 '58 DST 4264-88  
1hr 60' WM FP 36-50 BHP 565-  
82/30" log

D6A

Co.  
 Sec.  
 No.  
 Sec.  
 T.  
 R.