


Section 21 Township 31 Range 10W

Well No. 1 Carter

Company Vickers

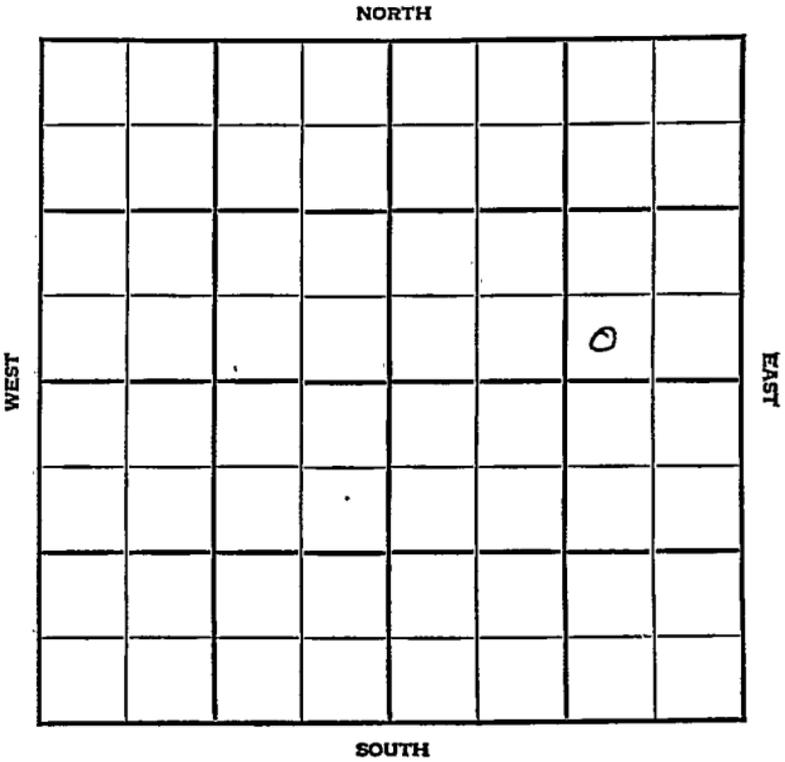


Sec. 21 Twp. 31 R. 10W

Well No. #1 Carter Farm

Vickers Company
Wildcat

 Ft. from N. Line
330 Ft. from S. Line
990 Ft. from E. Line
 Ft. from W. Line

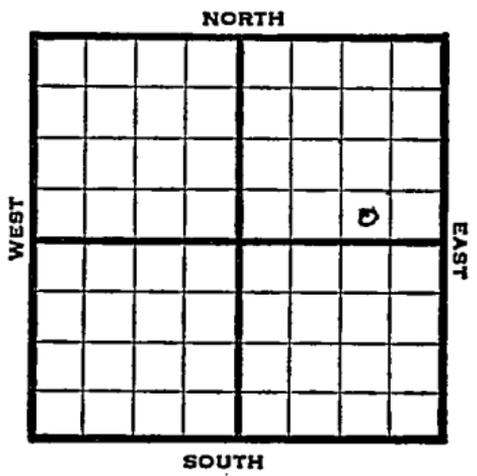

SW SE NE

1947	Elev. 1648' REPORT
12/17	10" @ 220' Drlg. 500'
12/30	Lansing 3765' Drlg. 2960'
1948 1/8	Miss. 4444' Drlg. 4536'
1/14	Viola 4772' Simp. 4818' Arb. 4927' TD 4990' Abd. -
	$ \begin{array}{r} 4772 \quad 4818 \\ 1648 \quad 1648 \\ \hline 3124 \quad 3170 \end{array} $
	ABANDONED

Map No. _____ Sec. 21 Twp. 31 R. 10W

Well No. 1 Carter

Vickers Company

FIRST REPORT Contractor

SW SE NE

SECTION PLAT

_____ Ft. from N. Line

330 Ft. from S. Line

990 Ft. from E. Line

_____ Ft. from W. Line

			o

Barber County

Location _____

Rig up _____

Drilling and Remarks:

10" @ 220

drlg. 500

RECORD

Cased _____ in., _____ ft.

Sand _____

Gas _____

Oil _____

Total Depth _____

PRODUCTION

1st 24 hrs. Nat. _____

1st 24 hrs. after shot _____

Gas _____ Cu. Ft.

Dry Hole _____

Abandoned _____

Date

DEC 17 1947 19 _____

S. J. LEWIS Scout