FORM 51 10M 2-49 PETRO

KANSAS


Stevens

Section 21 Township 31 Range 37W

Well No. 1 Nesse

Company Hugoton Prod.

Hugoton

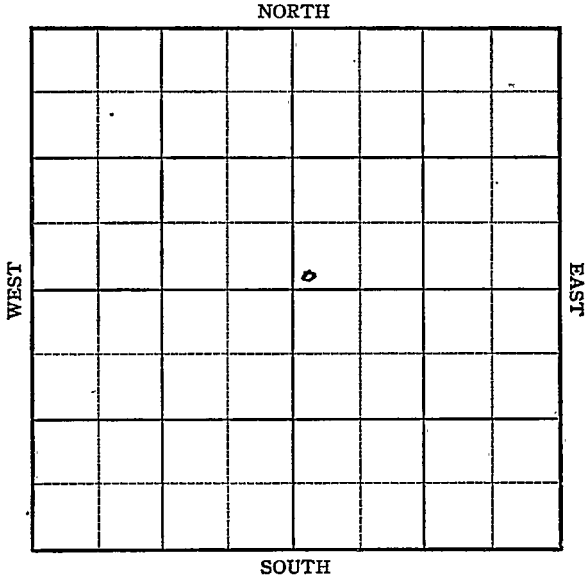

FORM 252-A
5M 10-48 PETROL

KANSAS


Stevens

Sec. 21 Twp. 31 R. 37W ✓

Well No. #1 Nesse Farm

Hugoton Prod. Company

Hugoton Pool (Burris, Cont.)

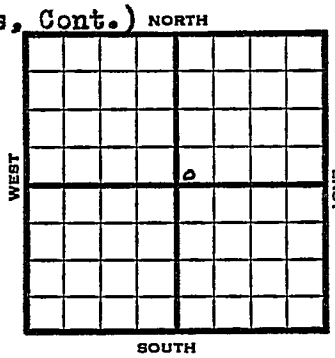

____ Ft. from N. Line

45' Ft. from S. Line

____ Ft. from E. Line

70' Ft. from W. Line

SW NE

1949	Elev 3109' REPORT
5/18	Location
5/25	Surface Hole
6/1	10" @ 560' 7" @ 2515' TD 2515'
6/7	Drlg 2660'
6/15	TD 2754' 252' of 5" Perf liner @ 2754'
6/21	"
6/29	TD 2754' 7"@ 2515' 252' of 5" Perf Liner @ 2754' 6,038,000 Gas 416# R Pr. Comp

COMPLETED

Form 26 200 Bks. 9-48 Petrol

Kansas

Hugoton Pool

Map No. _____ Sec. 21 Twp. 31 R. 37W

Well No. 1 Nesse


Hugoton Prod. Company

Burris Contractor

SW NE

FIRST REPORT

SECTION PLAT

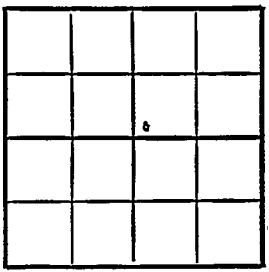

_____ Ft. from N. Line

45 Ft. from S. Line

_____ Ft. from E. Line

70 Ft. from W. Line

Stevens County

Location X

Rig up

Drilling and Remarks:

RECORD

Cased _____ in., _____ ft.

Sand

Gas

Oil

Total Depth

PRODUCTION

1st 24 hrs. Nat.

1st 24 hrs. after shot

Gas _____ Cu. Ft.

Dry Hole

Abandoned

Date

MAY 18 1949 19

S. J. LEWIS Scout

Form 26 200 Bks. 6-49 Petrol

Kansas

Hugoton Pool

Map No. ____ Sec. 21 Twp. 31 R. 37W

Well No. 1 Nesse


Hugoton Prod. Company

COMPLETE Contractor

SW NE

E 1,310'

SECTION PLAT

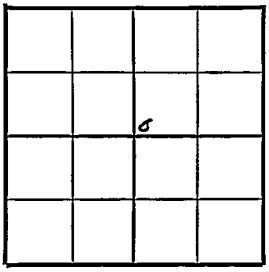

____ Ft. from N. Line

45 Ft. from S. Line

____ Ft. from E. Line

70 Ft. from W. Line

Stevens County

Location

Rig up

Drilling and Remarks:

7" @ 2515'

252' of 5" Pay Liner

@ 2554'

6,035,000 Gas

416# RP

RECORD

Cased ____ in., ____ ft.

Sand

Gas

Oil

Total Depth 2554

PRODUCTION

1st 24 hrs. Nat.

1st 24 hrs. after shot.

Gas ____ Cu. Ft.

Dry Hole

Abandoned

Date

JUN 29 1949 19

S. J. LEWIS Scout