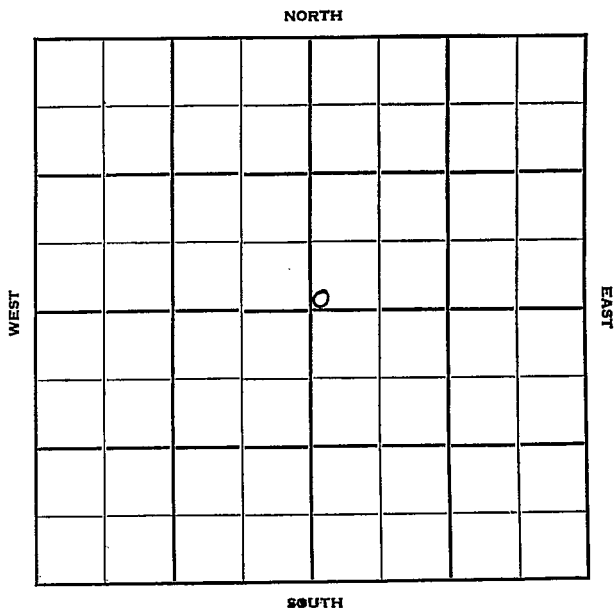


Section 21 Township 31 Range 33 WWell No. # 1 Becker "B"Company Stanolind

Seward

KANSAS

Sec. 21 Twp. 31 R. 33W

Well No. #1 Becker "B" Farm

Stanolind Company

Contractor

Hugoton Pool


 Ft. from N. Line

150' Ft. from S. Line

 Ft. from E. Line

150' Ft. from W. Line

SW SW NE

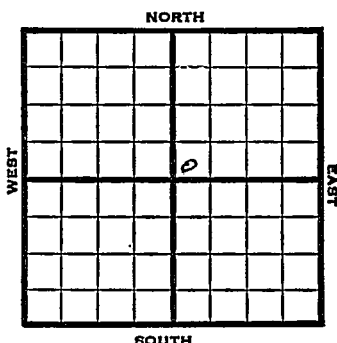

1951

Elev. 2887' REPORT

5/23

Location

8/1

Spud 6-28-51

Gas Well TD 2756

10" @ 681

Hol. 2579

Her. 2609

Krider 2619

Win. 2696

Ft. Riley 2638

TD 2756

6" @ 2640 96/2696-2712


42/2649-56 72/2660-72

120/2617-37 5500 A

Comp. 15,625,000 gas 385#

COMPLETED

County Seward State Kansas
 Sec. 21 (Blk.
Twp.) 31 (Sur.
Rge.) 33W Map No.
 Operator Stanolind
 Well No. 1 Farm Becker "B"
 Elev. 2887 Location SW SW NE

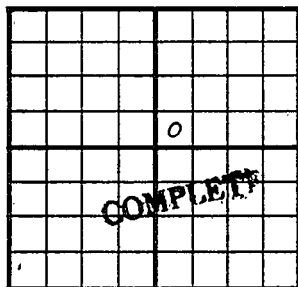

150 Ft. From S Line NE
150 Ft. From W Line Quarter

1st. Report

Completion AUG 1 1951

Remarks Hugoton Pool

Spudding Date 6-28-51

Drilg. Data Gas well TD 2756

10" @ 681 Hol. 2579 Her. 2609

Krider 2619 Win. 2696 Ft. Riley 2638

TD 2756 6" @ 2640 96/ 2696-2712

42/ 2649-56 72/ 2660-72 120/ 2617-37

5500 A Comp. 15,625,000 gas 385#

J. E. TYRA