


Section 21 Township 31 Range 35-W
Well No. #1 Leffler-Caskill
Company Magnolia

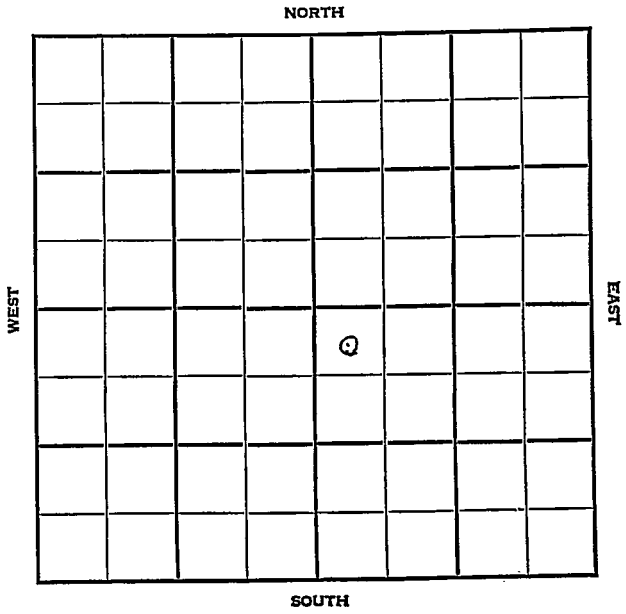

KANSAS

Stevens

Sec. 21 Twp. 31 R. 35W

Well No. #1 Leffler-Gaskill Farm

Magnolia Company

Hugoton Pool


NORTH

330' Ft. from N. Line

_____ Ft. from S. Line

_____ Ft. from E. Line

330' Ft. from W. Line

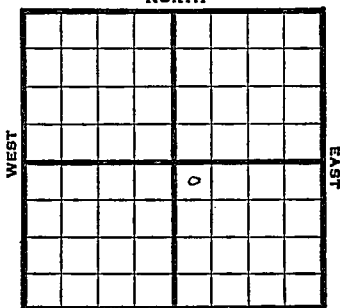

NW SE

SOUTH

1948

Elev. 3006' REPORT

7/21 10" @ 632'

7/28 "

8/4 Drlg. 2680'

8/11 "

8/18 TD 2824'

7" @ 2823'

192 s ots 2690-2738 7000 acid

120 shots 2640-64 7000 acid

144 shots 2588-2620 7000 acid

8/25 2' "

9/1 " "

9/8 TD 2828'

7" @ 2823'

Perf.

Acid 21,000

Gas 20,450,000

R. Pr. 410#

COMPLETED

Map No. _____ Sec. 21 Twp. 31 R. 35W

Well No. 1 Leffler-Gaskill

Magnolia Company

1ST REPORT

Contractor _____

NW SE

SECTION PLAT

330 Ft. from N. Line

_____ Ft. from S. Line

_____ Ft. from E. Line

330 Ft. from W. Line

		6	

Stevens County

Location _____

Rig up _____

Drilling and Remarks:

10" @ 632

RECORD

Cased _____ in., _____ ft.

Sand _____

Gas _____

Oil _____

Total Depth _____

PRODUCTION

1st 24 hrs. Nat. _____

1st 24 hrs. after shot _____

Gas _____ Cu. Ft.

Dry Hole _____

Abandoned _____

Date

JUL 21 1948

19

S. J. LEWIS

Scout

Stevens County Kansas State
35W
 Map No. _____ Sec. 21 Twp. 31 R. _____

Well No. 1 Leffler-Gaskill

Magnolia Company

COMPLETE

Contractor

NW SE

E. 1,3006

SECTION PLAT

330 Ft. from N. Line

_____ Ft. from S. Line

_____ Ft. from E. Line

330 Ft. from W. Line

Hugoton Pool

Remarks:

7102825

7" @ 2823

Prof.

21000 acid

20,450,000 Gall

410 # R/F

Date
 SEP 8 1948

Scout S. J. LEWIS