
Sumner · KANSAS

SECTION 21 TOWNSHIP 31 RANGE 2W

WELL NO. #2 Beatie

COMPANY Gulf Oil Corp.

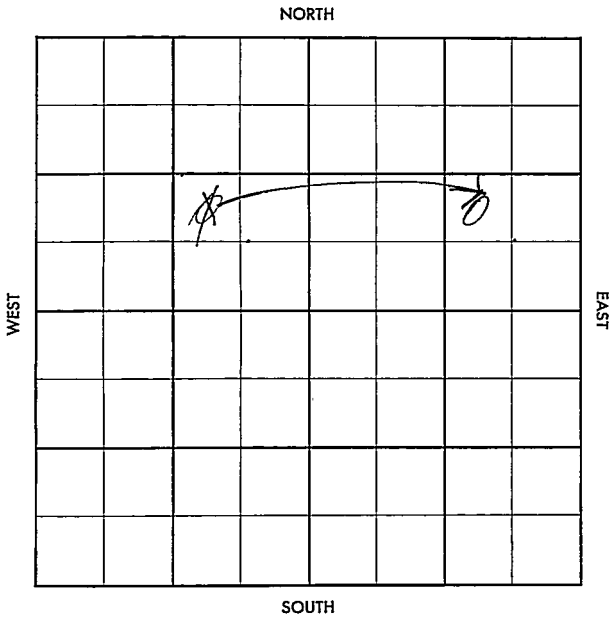

FORM 504-3 SUNRAY

FORM 513 SUNRAY

County Sumner Elev.

Sec. 21 Twp. 31 Rge. 2W

Company Gulf Oil Corp.

Farm Name Beatie No. 2


TOPS	DEPTH	LOG	DATUM
Anh.			
Tp.			
H.			
Tr.			
Dg.			
B.L.			
L.			
K.C.			
B.K.C.			
Ce.			
C.			
M.			
M.			
K.			
Mz.			
Mq.			
V.			
S.			
S.			
A			
R.			
P€.			
G.			
T.D.			

Loc. in Sec. NW SE NW

Geol.

Contr.

Pool

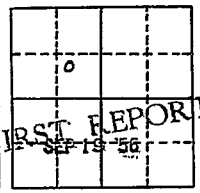

Date Comm. SEP 26 '56

Location

APP. 9-5-56

Co. Lse. No. Sec. T. R.

CORRECTION

FORM 513 SUNRAY

County Sumner Elev. 1258

Sec. 21 Twp. 31 Rge. 2W

Company Gulf Oil Corp. To be swd.

Farm Name Beatie No. 2


TOPS	DEPTH	LOG	DATUM
Anh.	455		
T.p.	2070		
H.	2469		
Tr.			
Dg. Stall		2729	
Bl.			
L.	3098		
K.C.			
B.K.C.			
Ce.			
C.			
M.		3782	
M.			
K.			
Mz.			
Mc.			
V.			
S.	4200		
S.			
A	4292	4294	
R.			
P€			
G.			
T.D.	4521		

Loc. in Sec. ~~NW SE NW~~ NW SE NE

Geol. Lewis

Contr.

Pool Beatie

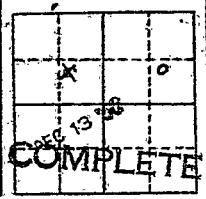

Date Comm.

Location SEP 26 '56 9-24-56

D #347 OCT 3 '56 8 5/8 467/375

D 3287 OCT 10 '56 DST 3262-3302

op 25" rec 35' Md BHP 1320

/30" D 4195 OCT 17 '56 DST 4197

-4203. 1 hr 415' SW FP 0-150

BHP 1566 /30" DST 4212-26

op 1 hr 1100' SW FP 60-480

BHP 1580 /30" DST 4344-4521

FORM 513-1 SUNRAY

55" nc 3824 brackish wtr
BHP 1850/15" 6" @ 4351
1/100 PB 4311 OCT 24 '56 OCT 31 '56
NOV 7 '56 NOV 13 '56 NOV 21 '56 NOV 28 '56 DEC 5 '56 DEC 12 '56
CO 4521 Tbg to 4421 (2)
Input 40 Bw in 8 minutes
comp. for SWD well.

21 31 2W