


Section 21 Township 31 Range 8 W

Well No. # 1 Burgess

Company Musgrove Petroleum

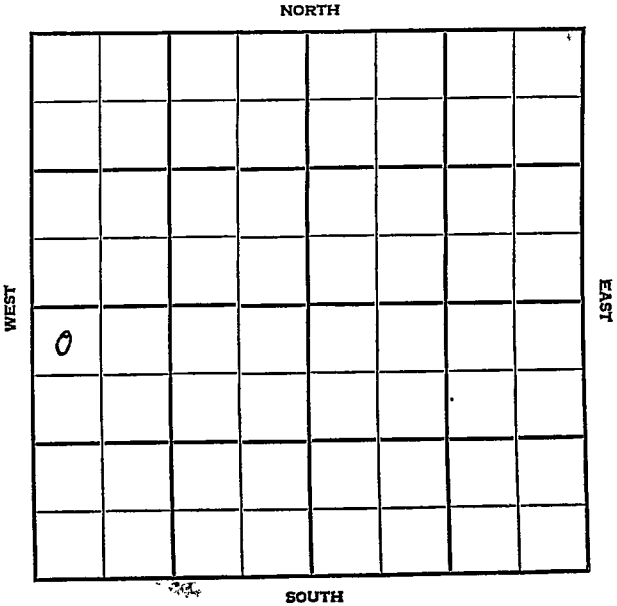

SEC.	21	TWP.	31	R.	8W
------	----	------	----	----	----

WELL NO.

#1 Burgess

FARM

COMPANY

Musgrove Petroleum

CONTRACTOR

Co. tools

Wildcat.

330

Ft. from N. Line

Ft. from S. Line

Ft. from E. Line

330

Ft. from W. Line

NORTH							
WEST	0						EAST
SOUTH							

NW NW SW

Magnolia - AC & DHM

Stanolind - DHM

1954

ELEVATION

1575'

REPORT

12/29

Spud 12-24-54

8" @ 200'

Anhy 1090'

Drlg. 1970'

1955

2/9

Spud 12-24-54

Oil well TD 4419' 8" @ 200

Anhy 1090' Heeb 3379 Tor 3400

Doug 3465 Lans 3624 KC 3880

DST 4032-82 open 1 hr rec 230' mud

1425# Miss 4369

DST 4368-77 open 1 hr gas in 29 min,
rec 55' SO & GCM. 1585#

DST 4377-93 open 1 hr gas in 14 min

rec 75' HO & GCM., 210' free oil,


30' wtr. 1485#. TD 4419 5" @ 4419

CO to 4412 15/4382-87 30 GOPH

5 hr. frac. F/7½ BOPH 9 hr.

Comp. F/185 BOPD 10% wtr.

COMPLETED

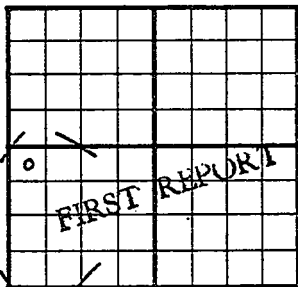County Harper State KansasSec. 21 (Blk. Twp.) 31 (Sur. Rge.) 8W Map No.Operator Musgrove PetroleumWell No. 1 Farm BurgessElev. Location NW NW SW330 Ft. From N Line SW330 Ft. From W Line Quarter1st. Report DEC 29 1954

Completion

Remarks Magnolia - AC & DEM
Stanolind - DEMCo. toolsSpudding Date 12-24-54Drlg. Data Wildcat8" @ 200 Anhy 1090 drlg. 1970


FABEN GILSTRAP

County Harper State Kansas
 Sec. 21 (Blk.) 31 (Sur.) 8W Map No.

Operator Musgrove Pet.

Well No. 1 Farm Burgess

Elev. 1575 Location NW NW SW

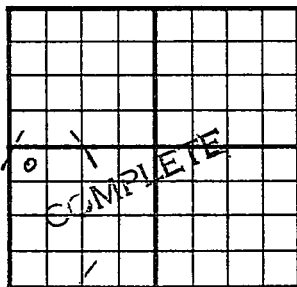

330 Ft. From N Line SW

330 Ft. From W Line Quarter

1st. Report

Completion FEB 9 1955

Remarks Grabs Pool

Co. tools

Spudding Date 12-24-54

Drlg. Data Oil well TD4419

8" @ 200 Anhy 1090 Heeb. 3379

Tor. 3400 Doug. 3465 Lans. 3624

KC 3880 DST 4032-82 open 1 hr.

Rec. 230' mud 1425# Miss. 4369

DST 4368-77 open 1 hr. gas in 29 min.

Rec. 55' so & gcm 1585# DST 4377-93

open 1 hr. gas in 14 min. Rec. 75' ho &

gcm 210' free oil 30' wtr. 1485#

TD 4419 5" @ 4419 CO to 4412

15/ 4382-87 30 goph 5 hr. frac

F/ 7 $\frac{1}{2}$ boph 9 hr.

Comp. F/ 185 bopd 10% wtr.

FABEN GILSTRA