

Section 21 Township 31 Range 8 WWell No. # 1 Burgess "A"Company Musgrove Pet.

NORTH

WEST

					0		

EAST

SOUTH

Harper KANSAS

SEC.	TWP.	R.
21	31	8W

WELL NO.

1 Burgess "A" FARM

COMPANY

Musgrove Petr.

CONTRACTOR


Co. Tools
Wildcat

330 Ft. from N. Line

Ft. from S. Line

Ft. from E. Line

990 Ft. from W. Line

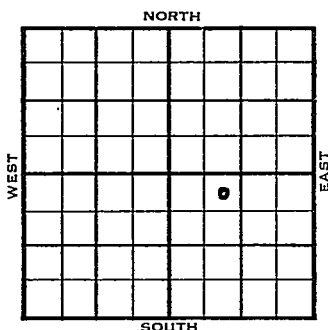

NE NW SE

Stanolind & Superior DHM

	ELEVATION	REPORT
1955	1573'	

2/9

Spud 2-5-55

8" @ 174'


Drlg. 1680'

3/23

Spud 2-5-55, oil well, TD
4445, 8" @ 174, Heeb 3367,
Tor 3385, Doug 3430, Doug sd
3444, Lans 3604, Stal 3613,
KC 3880, Miss 4379,
DST 4381-4405, open 1 hr, Rec
120' SOCM 120' HOCM, 210'
MCO, 30' wtr 1420#
TD 4445, 5" @ 4435, CO to 4425
36/4383-92, 36 G6PH 5 hr
ad-oil-frac S/16 BFPH 20%
wtr.
Comp. 141 BOPD 63%

COMPLETED

FABEN GILSTRAP

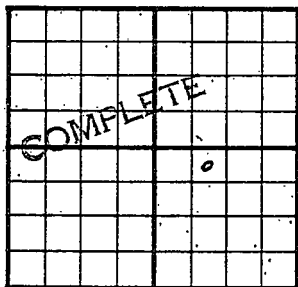County Harper State KansasSec. 21 (Blk. Twp.) 31 (Sur. Rge.) 8W Map No.Operator Musgrove Pet.Well No. 1 Farm Burgess "A"Elev. 1573 Location NE NW SE330 Ft. From N Line SE990 Ft. From W Line Quarter1st. ReportCompletion MAR 23 1955Remarks WildcatCo. toolsSpudding Date 2-5-55Drlg. Data Oil well TD 44458" @ 174 Heeb. 3367 Tor. 3385Doug. 3430 Doug. sd. 3444 Lans. 3604Stal. 3613 KC 3880 Miss. 4379DST-4381-4405 open 1 hr. Rec. 120' socm120' hocm 210' mco- 30' wtr. 1420#TD 4445 5" @ 4435 CO to 442536/ 4383-92 36 goph 5 hr. sd-oil-fracS/ 16 bfph 20% wtr. Comp. 141 bopd 63%

FABEN GILSTRAP