


KANSAS Stevens

Section 22 Township 31 Range 38W

Well No. 1 Leonard

Company Kansas Natural Gas

Hugoton Pool

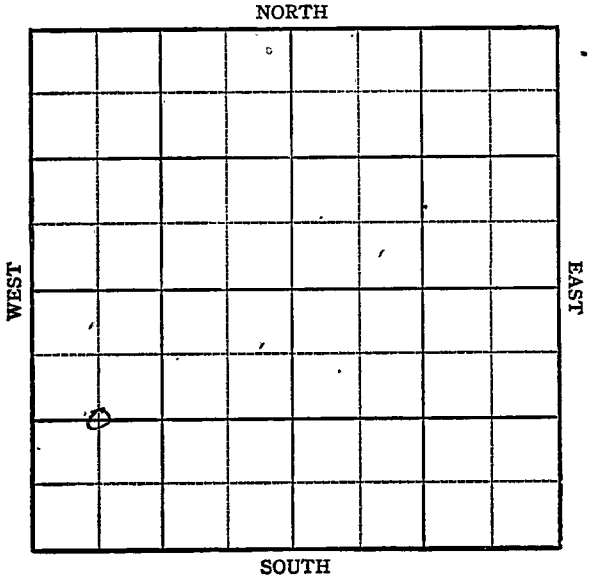

Sec. 22 Twp. 31 R. 38-W ✓

Well No. #1 Leonard Farm _____

Kansas Natural Gas Company
Hugoton


1320 Ft. from N. Line

_____ Ft. from S. Line

_____ Ft. from E. Line

660 Ft. from W. Line

C W $\frac{1}{2}$ SW

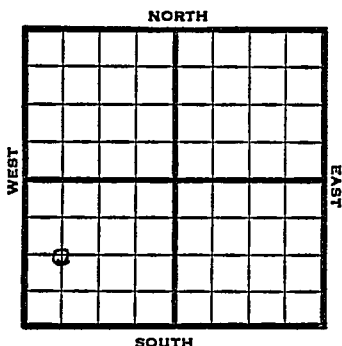

1948	Eli 3138'	REPORT
10/6	Surface Hole	
10/13	10" @ 505'	
	TD 2452	
	Run 7"	
10/19	"	
10/26	7" @ 2442'	
	TD 2619'	
	8000 acid	
11/3	Total 33500 acid	
11/10	"	
11/16	"	
11/23	"	
11/30	"	
12/6	"	
12/15	TD 2619'	
	7" @ 2442'	
	33500 acid	
	38,429,000 Gas	
	372# R Pr.	
	Comp	
	COMPLETED	

Map No. _____ Sec. 22 Twp. 31 R. 38W

Well No. 1 Leonard

Kansas Natural Gas Company

FIRST REPORT

Contractor

C $W\frac{1}{2}$ SW

SECTION PLAT

1320 Ft. from N. Line

_____ Ft. from S. Line

_____ Ft. from E. Line

660 Ft. from W. Line

Stevens County

Location _____

Rig up _____

Drilling and Remarks:

surface hole

RECORD

Cased _____ in., _____ ft.

Sand _____

Gas _____

Oil _____

Total Depth _____

PRODUCTION

1st 24 hrs. Nat. _____

1st 24 hrs. after shot _____

Gas _____ Cu. Ft.

Dry Hole _____

Abandoned _____

Date

OCT 6 1948

19

S. J. LEWIS

Scout

Map No. _____ Sec. 22 Twp. 31 R. 38W

Well No. 1 Leonard

Kansas Natural Gas Company

COMPLETE

Contractor

C W $\frac{1}{2}$ SW

E. I. B. B. S.

SECTION PLAT

1320 Ft. from N. Line

_____ Ft. from S. Line

_____ Ft. from E. Line

660 Ft. from W. Line

Stevens County

RECORD

Location _____

Cased _____ in., _____ ft.

Rig up _____

Sand _____

Drilling and Remarks:

Gas _____

7" C 2442

Oil _____

3350000000

Total Depth *2619*

38,429,000 gal

PRODUCTION

1st 24 hrs. Nat. _____

1st 24 hrs. after shot _____

Gas _____ Cu. Ft.

Dry Hole _____

Abandoned _____

3924 R B

Date

DEC 15 1948 19

S. J. LEWIS Scout