
DX 78-1

Harper KANSAS

Section 22 Township 31 Range 8 W

Well No. #2 Williams

Company Superior Oil

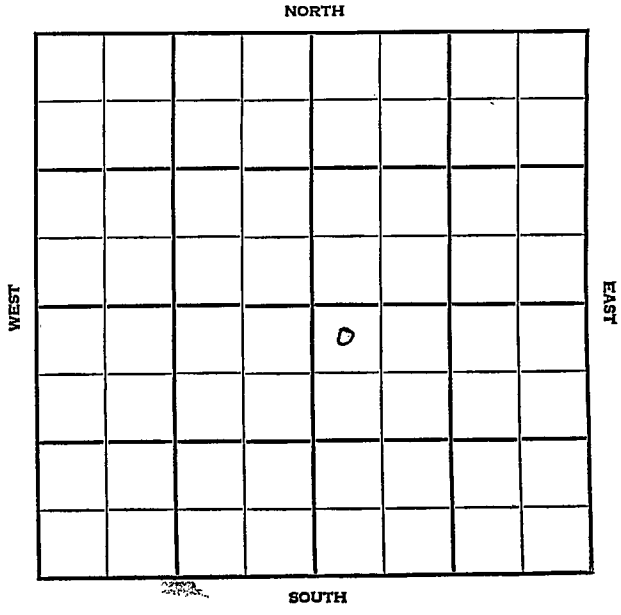

Harper KANSAS

SEC.	TWP.	R.
22	31	8W

WELL NO.
#2 Williams FARM

COMPANY
Superior Oil Co.

CONTRACTOR
Peel
Grabs


_____ Ft. from N. Line

_____ Ft. from S. Line

_____ Ft. from E. Line

_____ Ft. from W. Line

NW NW SE

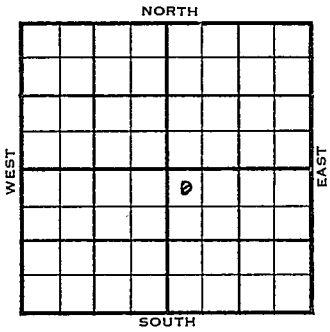

1955	ELEVATION 1591' REPORT
9/7	Comm 9-2-55 10" @ 305/250 Drlg 1925
9/28	Comm 9-2-55 10" @ 305/250 M 4387 TD 4460 DST 4389-4403 open 1 hr gas in 4 min 277 mcfg Rec 40' gcm 1570/30" DST 4390-4412 open 1 hr gas in 4 min 340 mcfg Rec 244' gcm 1560/30" DST 4412-60 open 1 hr Rec 90' fluffy gcm 1880' sw 1555/20" 7" @ 1550/750 CO to 1885 Comp SWD well COMPLETED

DX-78

FORM 513 REV. SUNRAY

County Harper Elev.

Sec. 22 Twp. 31 Rge. 8W

Company Superior Oil

Farm Name Williams No. 2

TOPS	DEPTH	LOG	DATUM
Anh.			
Tp.			
H.			
Tr.			
Dg.			
Bl.			
L.			
K.C.			
B.K.C.			
Ce.			
C.			
M.			
M.			
K.			
Mz.			
Mo.			
V.			
S.			
S.			
A			
R.			
P€.			
G.			
T.D.			

Loc. in Sec. NW NW SE

Geol.

Contr. Peel

Pool Grabs

FIRST REPORT

6

SEP 7 '55

Date Comm. 9-2-55

10" @ 305/250 drlg. 1925

Co. Lse. No. Sec. T. R.

SEP 12 1955

Scout Cards
Land Small Map
Land Wall Map
Tracings
France Map
Pierce Map
Misc.

FORM 513 REV. SUNRAY

County Harper Elev. 1591

Sec. 22 Twp. 31 Rge. 8W

Company Superior Oil

Farm Name Williams No. 2


TOPS	DEPTH	LOG	DATUM
Anh.			
Tp.			
H.			
Tr.			
Dg.			
Bl.			
L.			
K.C.			
B.K.C.			
Ce.			
C.			
M.		4387	2796
M.			
K.			
Mz.			
Mo.			
V.			
S.			
S.			
A			
R.			
Pe.			
G.			
T.D.	4460		

Loc. in Sec. NW NW SE

Geol.

Contr. Peel


Pool Grabs

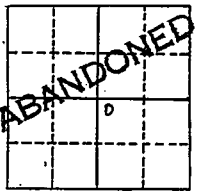

Date Comm. 9-2-55 SEP 28 1955

10" @ 305/250 DST 4389-4403 open 1 hr.
gas in 4 min. 277 mcfg Rec. 40' gcm
1570/30" DST 4390-4412 open 1 hr.
gas in 4 min. 340 mcfg Rec. 244' gcm
1560/30" DST 4412-60 open 1 hr.
Rec. 90' fluffy gcm 1880' SW 1555/20"
7" @ 1550/750 CO to 1885
Comp. SWD well

Co. Lse. No. Sec. T. R.

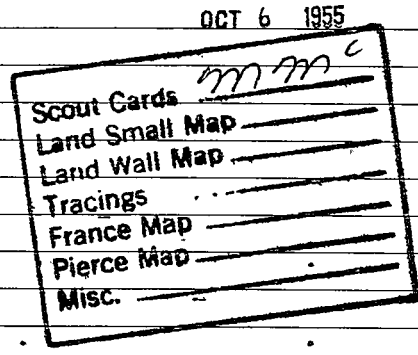
OCT 6 1955
mmc
Scout Cards
Land Small Map
Land Wall Map
Tracings
France Map
Pierce Map
Misc.