

Barber

KANSAS

SECTION 23 TOWNSHIP 31S RANGE 12W

WELL NO. #1 Updegraff


COMPANY Walters Drlg. Co.

NORTH

C NE SW

WEST

EAST

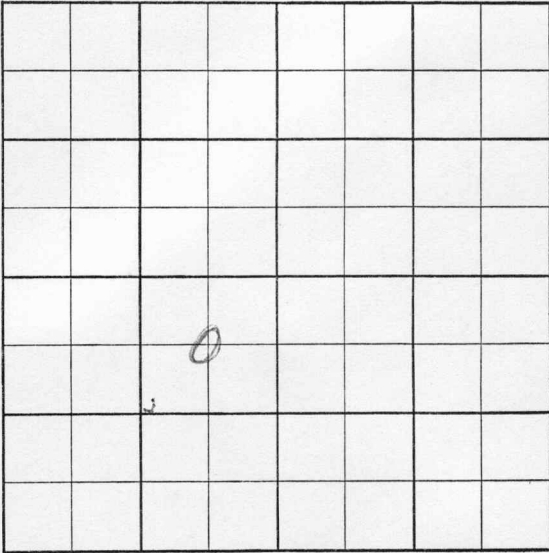

SOUTH

26

WILDCAT

S-513-B

County Barber Elev. _____
 Sec. 23 Twp. 31 Rge. 12W
 Company Walters Drlg. Co.
 Farm Name Updegraff No. 1

TOPS	DEPTH	LOG	DATUM
Anh.			
Tp.			
H.			
Tr.			
Dg.			
B.L.			
L.			
K.C.			
B.K.C.			
Ce.			
C.			
M.			
M.			
K.			
Mz.			
Mq.			
V.			
S.			
S.			
A.			
R.			
Pf.			
G.			
T.D.			

Loc. in Sec. C NE SW
 Geol. D. Costa
 Contr. _____
 Co. Tools # 1
 Pool Wildcat




Date Comm. 1/29/58 (Mull Drlg. - Ac & DHM)
8" @ 215 w/175, Drlg. 3000

Co.
Lse.
No.
Sec.
T.
R.

County Barber Elev. 1617 DF 1620 RB
 Sec. 23 Twp. 31 Rge. 12W
 Company Walters Drlg. Co.
 Farm Name Updegraff No. 1

TOPS	DEPTH	LOG	DATUM	Loc. in Sec.
Anh.				<u>C NE SW</u>
Tp.				
H.	<u>3561</u>			
Tr.				
Dg.	<u>5d</u>	<u>3610</u>		
B.L.				
L.		<u>3768</u>		Geol. <u>D. Costa</u>
K.C.				Confr.
B.K.C.		<u>4226</u>		<u>Co. Tools #1</u>
Ce.				Pool <u>Wildcat</u>
C.				
M.	<u>chut</u>	<u>4310</u>		
M.				
K.				
Mz.				
Mq.				
V.				
S.				
S.				
A.				
R.				
Pf.				
G.				
T.D.	<u>4350</u>			

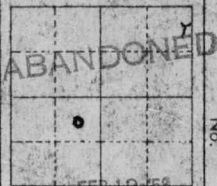

Date Comm. 1/29/58 (Mull Drlg. - Ac & DHM)
8" @ 215 w/175, Drlg. 3000 FEB 12 58 DST
3639-80° 60° 200' MW FP 170-50
BHP 1495-1395/30 DST 3720-27 89'
500' SW FP 360-170 BHP 1075-1415/20
9 1/5" ga 400-700 net DST 4312-30
120" g/110" TSTM 98' g/4 SOCM BHP
1690-1270/30 FEB 19 58 DST 4330-50
120" 1740' SW BHP 1700-1565/20
20109 DBA