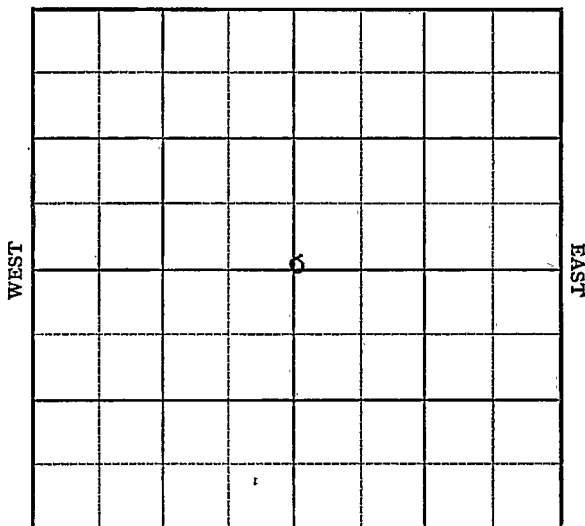


KANSAS

Stevens

Section 23 Township 31 Range 37WWell No. 1 AlexanderCompany Hugoton Prod.Hugoton
NORTH

SOUTH

KANSAS

Stevens

Sec. 23 Twp. 31 R. 37W

Well No. #1 Alexander Farm

Hugoton Prod.

Company


Hugoton Pool

2640' Ft. from N. Line

Ft. from S. Line

2640' Ft. from E. Line

Ft. from W. Line

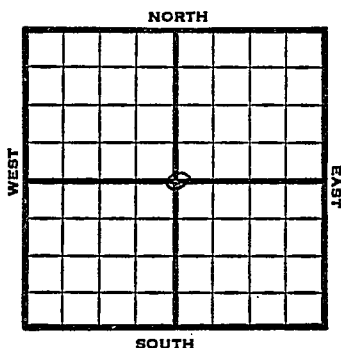

C Sec.

1949

Elev 3079'

REPORT

3/23

Location

3/30

10" @ 560'

Drilg. 1430'

4/6

TD 2535'

7" @ 2517'

4/12

TD 2755'

278' of 5" Perf liner @ 2750

4/20

"

4/27

"

5/4

"

5/10

"

5/18

"

5/25

"

6/1

"

6/7

"

6/15

"

6/21

"

6/29

TD 2750'

7" @ 2517'

278' of 5" Perf Liner @ 2750'

3,532,000 Gas

425# R Pr.

Comp

COMPLETED

Map No. _____ Sec. 23 Twp. 31 R. 37W

Well No. 1 Alexander

Hugoton Prod. Company

FIRST REPORT

Contractor

C Sec.


SECTION PLAT

2640 Ft. from N. Line

_____ Ft. from S. Line

2640 Ft. from E. Line

_____ Ft. from W. Line

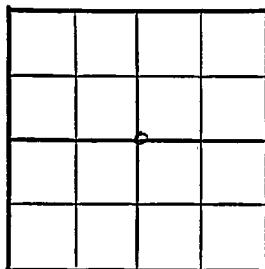

Stevens County

Location X

Rig up _____

Drilling and Remarks:

RECORD

Cased _____ in., _____ ft.

Sand _____

Gas _____

Oil _____

Total Depth _____

PRODUCTION

1st 24 hrs. Nat. _____

1st 24 hrs. after shot _____

Gas _____ Cu. Ft.

Dry Hole _____

Abandoned _____

Date

MAR 23 1949

19

S. J. LEWIS

Scout

Map No. 1 Sec. 23 Twp. 31 R. 37W

Well No. 1 Alexander

Hugoton Prod. Company

COMPLETE

Contractor

C Sec.


21,307.
SECTION PLAT

2640 Ft. from N. Line

 Ft. from S. Line

2640 Ft. from E. Line

 Ft. from W. Line

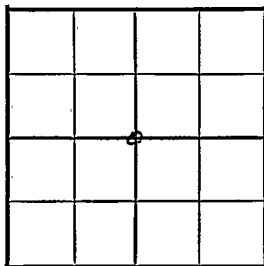

Stevens County

Location

Rig up

Drilling and Remarks:

7" @ 2517

278' 5/8" Pay line

@ 2750

3,532,800 Gas

42.5 # R/R

RECORD

Cased in., ft.

Sand

Gas

Oil

Total Depth 2250

PRODUCTION

1st 24 hrs. Nat.

1st 24 hrs. after shot

Gas Cu. Ft.

Dry Hole

Abandoned

Date

JUN 29 1949

19

S. J. LEWIS

Scout