


Section 23 Township 31 Range 33W

Well No. 1 Armour

Company Warren Pet.

Hugoton Pool
NORTH

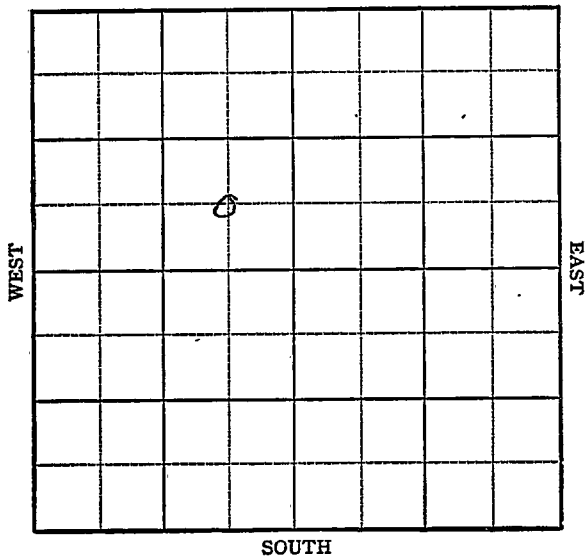

KANSAS

Seward

Sec. 23 Twp. 31 R. 33W

Well No. #1 Armur Farm

Warren Pet.

Company

Hugoton Pool

_____ Ft. from N. Line

660'


_____ Ft. from S. Line

660'

_____ Ft. from E. Line

_____ Ft. from W. Line

C. SE NW

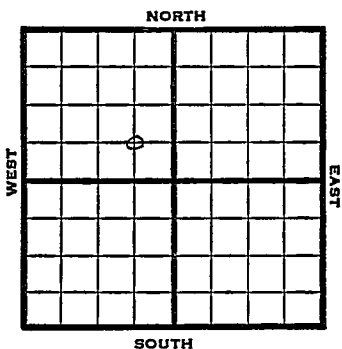

1948

in

Eli 2878'

REPORT

10/27

RUR

11/3

10" @ 544'

Drlg 2856'

11/10

TD 2616'

11/16

TD 2725'

127' of 5" Perf liner @ 2725

12,000 acid

11/23

"

12/1

TD 2725'

7" @ 2615'

127' of 5" Perf liner @ 2725'

2000 acid

12,068,000 Gas

340# R Pr.

Comp

COMPLETED

Map No. _____ Sec. 23 Twp. 31 R. 33W

Well No. 1 Armour

Warren Pet. _____ Company

FIRST REPORT _____ Contractor

C SE NW

SECTION PLAT

_____ Ft. from N. Line

660 Ft. from S. Line

660 Ft. from E. Line

_____ Ft. from W. Line

Seward County

Location _____

Rig up _____

Drilling and Remarks:

R U R

RECORD

Cased _____ in., _____ ft.

Sand _____

Gas _____

Oil _____

Total Depth _____

PRODUCTION

1st 24 hrs. Nat. _____

1st 24 hrs. after shot _____

Gas _____ Cu. Ft.

Dry Hole _____

Abandoned _____

Date

OCT 27 1948 19

S. J. LEWIS Scout

Map No. _____ Sec. 23 Twp. 31 R. 33W

Well No. 1 Armur

Warren Pet. Company

COMPLETE Contractor

C SE NW

E. 2575
SECTION PLAT

_____ Ft. from N. Line

660 Ft. from S. Line

660 Ft. from E. Line

_____ Ft. from W. Line

	6		

Seward County

Location _____

Rig up _____

Drilling and Remarks:

7" @ 2615
127' x 15" Perf
line @ 2725
20000 cu ft
12,065,000 gal
340 R²*

RECORD

Cased _____ in., _____ ft.

Sand _____

Gas _____

Oil _____

Total Depth 2725

PRODUCTION

1st 24 hrs. Nat. _____

1st 24 hrs. after shot _____

Gas _____ Cu. Ft.

Dry Hole _____

Abandoned _____

Date

DEC 1 1948 19

S. J. LEWIS Scout