


Section 23 Township 31 Range 32 W
Well No. # 1 Chapple
Company Skelly Oil

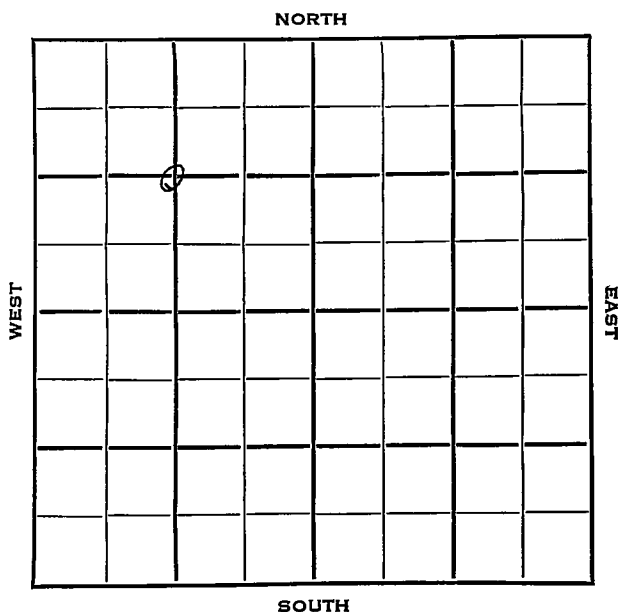

Seward KANSAS

SEC.	TWP.	R.
23	31	3 2W ✓
WELL NO.		
1 Chapple		
COMPANY		FARM
Skelly Oil		
CONTRACTOR		

Hugoton Pool


1250 _____ Ft. from N. Line

_____ Ft. from S. Line

_____ Ft. from E. Line

1250 _____ Ft. from W. Line

C NW/4

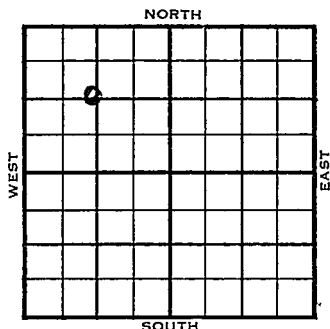

	ELEVATION	REPORT
1953	2853'	

12/2 Spud 11-28-53
8" @ 706'

12/9 RTD 2625'
Hol 2586'
Her 2623'

12/16 7" @ 2623'
CO 2625
Drlg 2630'

1954
1/6 Spud 11-28-53
Gas Well

TD 2736'
10" @ 706'
TD 2625'
Hol 2556', Her. 2623'
7" @ 2623'
Kri 2647', Win 2725'
DD 2736, 20,000A
Comp. 3 mcf/gpd

COMPLETED

J. G. McGEHEE

J. G. McGEHEE