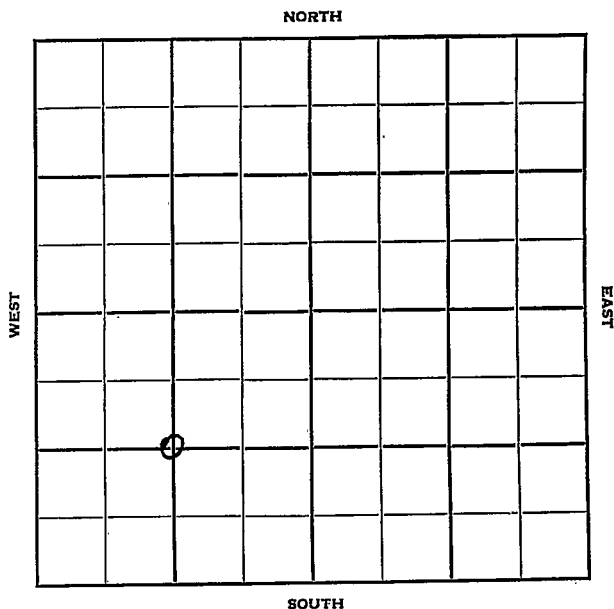


Comanche **KANSAS**
31 16WSection 23 Township 31 Range 16WWell No. #1 Robbins "B"Company Barbara Oil

Sec. 23 Twp. 31 R. 16WWell No. #1 Robbins "B" FarmBarbara Oil

Company

R.C. Patton

Contractor

Robbins Ranch Pool

Ft. from N. Line

1320


Ft. from S. Line

Ft. from E. Line

1320

Ft. from W. Line

C SW/4

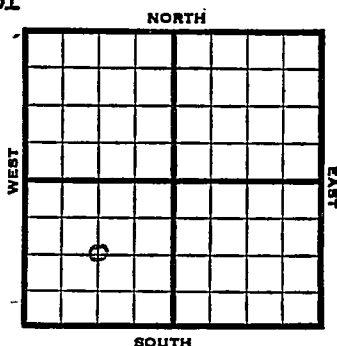

1953

Elev. 2039' REPORT

5/27

Location

6/3

10" @ 310

Drlg. 2700'

6/10

Drlg. 3954'

6/24

Lans 4348, Miss 4960

DST 4961-85, 1 hr., 3500' SW, 1705#

Drlg. 5148'

7/1

Spud 5-28-53

D & A

TD 5465'

10" @ 310'

Lans 4348, Miss 4960,

DST 4961-85 opn 1 hr, rec 3500' sw

1705# Viola 5238', Simp 5366', Arb

5435'

TD 5465'

D & A

ABANDONED

County Comanche State Kansas
 Sec. 23 (Blk.) 31 (Sur.) 16W Map No.
 Operator Barbara Oil
 Well No. 1 Farm Robbins "B"
 Elev. _____ Location C SW/4



1320 Ft. From S Line SW
1320 Ft. From W Line Quarter

1st. Report MAY 27 1953

Completion _____

Remarks _____

R.C. Patton - Contr.


Spudding Date _____

Drig. Data _____

Robbins Ranch Pool

Location

J. G. McGEHEE

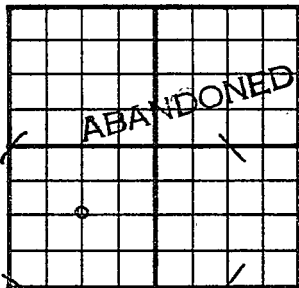County Comanche State KansasSec. 23 (Blk. 31 (Sur. 16W (Twp.) Map No.Operator Barbara OilWell No. 1 Farm Robbins "B"Elev. 2039 Location C SW/41320Ft. From S Line SW1320Ft. From W Line Quarter1st. ReportCompletion JUL 1- 1953Remarks Robbins Ranch PoolR.C. Patton - Contr.Spudding Date 5-28-53Drig. Data D & A TD 546510" @ 310 Lans. 4348 Miss. 4960DST 4961-85 open 1 hr. Rec. 3500' sw1705# Viola 5238 Simp. 5366Arb. 5435 TD 5465D & A