


FORM 51 Comanche KANSAS

Section 23 Township 31 Range 16W

Well No. 1 Robbins

Company Barbara Oil

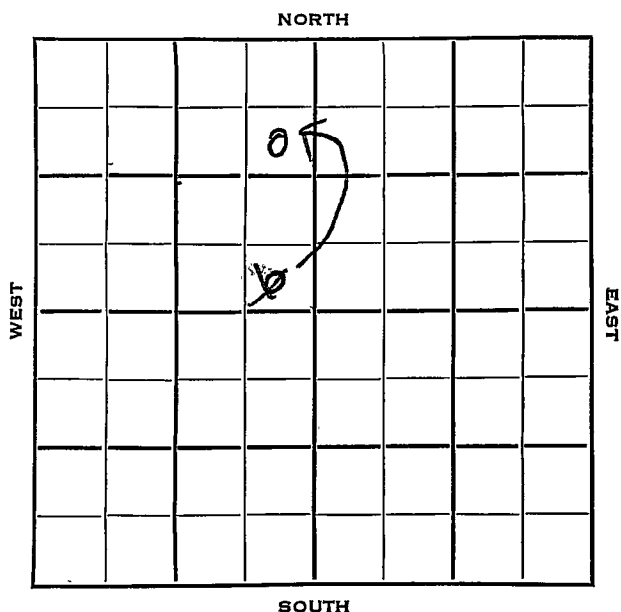

Gomanche
KANSAS

Sec. 23 Twp. 31 R. 16 W

Well No. # 1 Robbins Farm

Barbara Oil Company

Patton Drlg. Contractor

Wildcat

990 Ft. from N. Line


330 Ft. from S. Line

330 Ft. from E. Line

Ft. from W. Line

SE NE NW

SE SE NW

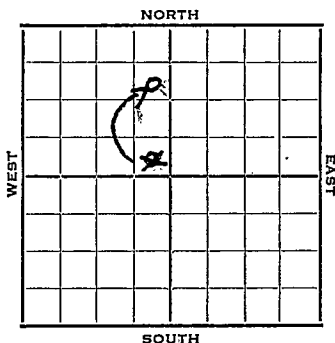

1952	Elev. 2004' REPORT
11/26	MIM
12/4	"
12/11	MIM
12/18	RUR
12/25	RUR
1/1	Drlg. 2975
1/8	Ø4285
1/22	Doug 3270, Lans 4284 DST 4415-29, 1 hr., 645' SW 1555# Miss 4886 DST 4888-4900, 25 mins., 1-1/4 M gas, 60' GCM, 1700# RTD 4900 5" @ 4888
1/29	CO
2/5	DD 4915'
2/12	TD 4930 PB 4915, Hyd Est 7 M gas
2/19	NR

OVER

#1 Robbins

1953

2/25

Spud 12-18-52

Gas Well

TD 4930

13" @ 301

Doug 3270, Lans 4284

DST 4415-29, opn 1 hr., rec.

645' sw, 1555#

Miss 4886

DST 4888-4900, opn 25 mins.,

1,225,000 gas, 60' gcm, 1700#

TD 4900

5" @ 4888

DD 4915

DD 4930

PB 4915 Hydro

Comp. 6 mcf/gpd

COMPLETED


County Comanche State Kansas

Sec. 23 (Blk. Twp.) 31 (Sur. Rge.) 16W Map No.

Operator Barbara Oil

Well No. 1 Farm Robbins

Elev. 2004 Location SE NE NW

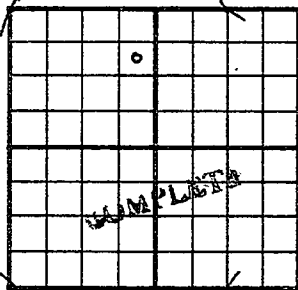

990 Ft. From N Line NW

330 Ft. From E Line Quarter

1st. Report

Completion FEB 25 1953

Remarks Wildcat

Patton Drlg. - Contr.

Spudding Date 12-18-52

Drlg. Data Gas well TD 4930

13" @ 301 Doug. 3270 Lans. 4284

DST 4415-29 open 1 hr. Rec. 645' sw

1555# Miss. 4886 DST 4888-4900

open 25 min. 1,225,000 gas 60' gcm

1700# TD 4900 5" @ 4888 DD 4915

DD 4930 PB 4915 Hydro.

Comp. 6 mcf gpd

J. G. McGEHEE

Map

4 753

Scout Cards

Land Small Map

Land Wall Map


Tracings

France Map

Pi - ce Map

MISC.

Orig. Data

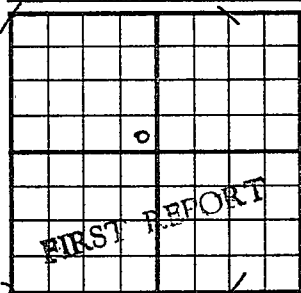County Comanche State KansasSec. 23 (Blk. 31) (Sur. 16W) Map No.Operator Barbara OilWell No. 1 Farm RobbinsElev. Location SE SE NW330 Ft. From S Line NW330 Ft. From E Line Quarter1st. Report NOV 26 1952

Completion

Remarks

Patton Drlg. - Contr.

Spudding Date

Drlg. Data WildcatM I M

J. G. McGEHEE

Scout Cards

Land Small Map

Land Wall Map

Tracings

France Map

Pierce Map

Misc

NOV 28 1952

Orig. Data

Map No. _____ Sec. 23 Twp. 31 R. 16WWell No. 1 Robbins

Barbara Oil _____ Company

CORRECTION

Contractor _____

SE NE NW

SECTION PLAT

990 Ft. from N. Line

_____ Ft. from S. Line

330 Ft. from E. Line

_____ Ft. from W. Line

	o		

Comanche County

Location _____

Rig up _____

Drilling and Remarks:

Reported
SE SE NW

RECORD

Cased _____ in., _____ ft.

Sand _____

Gas _____

Oil _____

Total Depth _____

PRODUCTION

1st 24 hrs. Nat. _____

1st 24 hrs. after shot _____

Gas _____ Cu. Ft.

Dry Hole _____

Abandoned _____

Date

J. G. McGEHEE

DEC 3 1952 19

Scout

Scout Cards	10
Land Small Map	
Land Wall Map	5
Tracings	
France Map	
Pierce Map	
Misc.	

DEC 5 1952