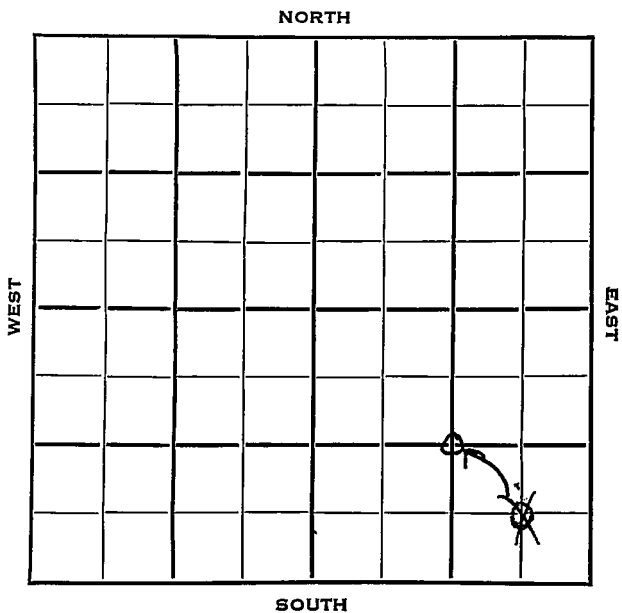


Section 23 Township 31 Range 16 WWell No. # 1 Robbins UnitCompany Barbara Oil

Comanche KANSAS ✓

Sec. 23 Twp. 31 R. 16W

Well No. #1 Robbins Unit Farm

Barbara Oil Company

Patton Drlg. Contractor

Robbins Ranch Pool

1320 Ft. from N. Line


660 Ft. from S. Line

1320 Ft. from E. Line

660 Ft. from W. Line

0 SE/4 Ft. from W. Line

0 SE SE

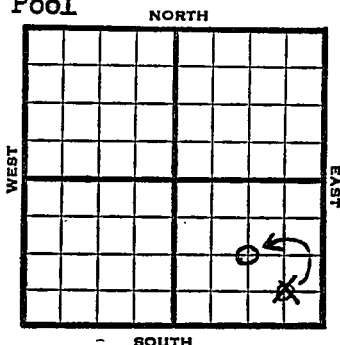

1953 Elev. 2035' REPORT

4/29 Spud 4-22-53
10" @ 291
Drlg. 2320'

5/7 Drlg. 3745'

5/21 Doug 4315, Lans 4326,
DST 4819-39 1 hr, 40' M / SSO 65#
Miss 4935, B. Chat 4950
DST 4934-51 1 hr, 5 1/2 M gas 25' clean
oil. 1690# 20" RTD 4958
7" @ 4946'


5/27 CO 4958, est 10 M gas

6/3 9,682,000 plus spray oil

6/10 NR

6/24 Spud 4-22-53
Gas Well
TD 4958
10" @ 291
Doug 4315, Lans 4326,
DST 4819-39, opn 1 hr., rec. 40' mud
& SSO 65#
Miss 4935, B. Chat 4950
DST 4934-51, opn 1 hr., rec. 5 1/2 mcfg
25' clean oil 1690#
TD 4958
7" @ 4946, CO to 4958, 10 mcfg
Comp 9,682,000 gas **COMPLETED**

County Comanche State Kansas
 Sec. 23 (Blk. Twp.) 31 (Sur. Rge.) 16W Map No.
 Operator Barbara Oil
 Well No. 1 Farm Robbins Unit
 Elev. _____ Location C SE SE

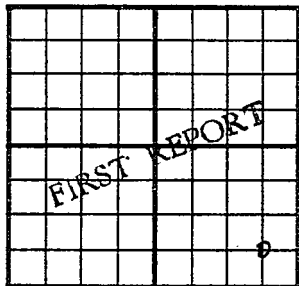

660 Ft. From S Line SE
660 Ft. From E Line Quarter
 1st. Report APR 29 1953
 Completion _____
 Remarks Patton Drlg. - Contr.
 Spudding Date 4-22-53


Drlg. Data Robbins Ranch Pool
10" @ 291 drlg. 2320

Map No. _____ Sec. 23 Twp. 31 R. 16WWell No. 1 Robbins UnitBarbara Oil Company**CORRECTION**

Contractor _____

C SE/4

SECTION PLAT

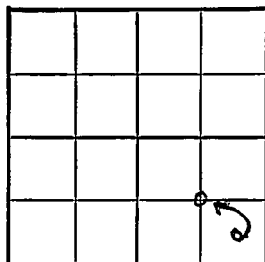

_____ Ft. from N. Line

1320 Ft. from S. Line1320 Ft. from E. Line

_____ Ft. from W. Line

Comanche County

Location _____

Rig up _____

Drilling and Remarks:

Reported

C SE SE

RECORD

Cased _____ in., _____ ft.

Sand _____

Gas _____

Oil _____

Total Depth _____

PRODUCTION

1st 24 hrs. Nat. _____

1st 24 hrs. after shot _____

Gas _____ Cu. Ft.

Dry Hole _____


Abandoned _____

Date

MAY 6 1953 19

J. G. McGEHEE Scout

County Comanche State Kansas
 Sec. 23 (Blk.) 31 (Sur.) 16W Map No.
 Operator Barbara Oil
 Well No. 1 Farm Robbins Unit
 Elev. 2035 Location C SE/4

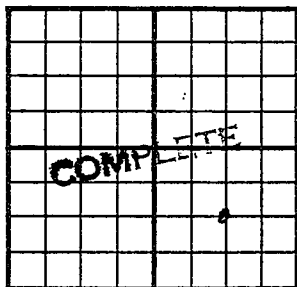

1320ft. From S Line SE
1320ft. From E Line Quarter

1st. Report

Completion JUN 24 1953

Remarks Robbins Ranch Pool
Patton Drlg. - Contr.

Spudding Date 4-22-53

Drlg. Data Gas well TD 4958

10" @ 291 Doug. 4315 Lens. 4326

DST 4819-39 open 1 hr. Rec. 40' mud &

SSO 65# Miss. 4935 B. chat 4950

DST 4934-51 open 1 hr. Rec. 5½ mcfg

25' clean oil 1690# TD 4958

7" @ 4946 CO to 4958 10 mcfg

Comp. 9,682,000 gas

J. G. McGEHEE