

SEC.	TWP.	R..
23	31	1W

WELL NO. **#3 Meller** FARM

COMPANY **Aladdih Pet Corp**

CONTRACTOR **Crowe Drlg**

NE Wellington


_____ Ft. from N. Line

_____ Ft. from S. Line

_____ Ft. from E. Line

_____ Ft. from W. Line

SW SE SW

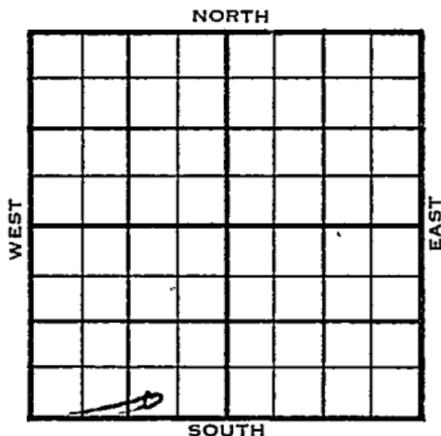

1955	ELEVATION	REPORT
	1278'	

11/9 Loc
 12-14 Comm. 11-12-55
 8 5/8" @ 319/200
 DST ~~3133~~50 op 1 hr. rec. 250' gas
 90' ho&gcm, 1250/20"
 5 1/2" @ 3710
 GO to 3688, 48/ 3648-64
 S/ 32 bo 3 hrs., 1500 A
 F/ 37 boph 2 hrs.
 Comp. F/ 736 bopd
 KC 2992-2986
 M. 3638-3638
 Dolo 3660-3650
 TD 3711'

COMPLETED

County Summer Elev. _____
 Sec. 23 (31) Rge. IW
 Company Abdoun Pet. Corp.
 FarmName Mellor No. 3

TOPS	DEPTH	LOG	DATUM
Anh.			
Tr.			
H.			
Tr.			
Dg.			
Bl.			
L.			
K.C.			
B.K.C.			
Ce.			
C.			
M.			
M.			
K.			
Mz.			
Mo.			
V.			
S.			
S.			
A.			
R.			
Pe.			
G.			
T.D.			

Loc. in Sec. SW SE SW


Geol. _____
 Contr. Crowe Drlg.

Pool NE Wellington

FIRST REPORT
 NOV 9 '55

Date Comm. _____
 Location _____

Co.
 Lse.
 No.
 Sec.
 T.
 R.

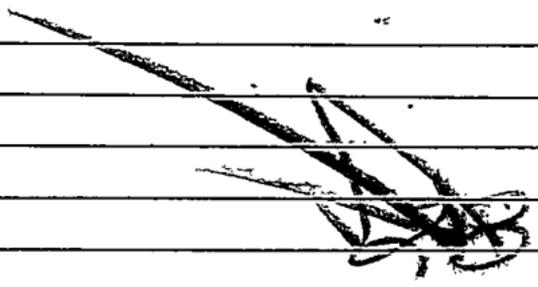

County Sumner Elev. 1278
 Sec. 23 Twp. 31 Rge. 1W
 Company Aladdin Pet.
 Farm Name Mellor No. 3

TOPS	DEPTH	LOG	DATUM
Anh.			
Tr.			
H.			
Tr.			
Dg.			
Bl.			
L.			
K.C.	<u>2992</u>	<u>2986</u>	<u>1708</u>
B.K.C.			
Ce.			
C.			
M.	<u>36.38</u>	<u>36.38</u>	<u>2360</u>
M. <i>dolo</i>	<u>36.60</u>	<u>36.50</u>	<u>2372</u>
K.			
Mz.			
Me.			
V.			
S.			
S.			
A			
R.			
Pe.			
G.			
T.D.	<u>3711</u>		

Loc. in Sec. SW SE SW
 Geol. _____
 Contr. Crowe Drlg.
 Pool NE Wellington
 COMPLETE

Date Comm. 11-12-55 DEC 14 1955
8 5/8" @ 319/200 DST 3 133-50 open 1 hr.
rec. 250' gas 90' ho & gcm 1250/20"
5 1/2" @ 3710 CO to 3688 48/ 3648-64
S/ 32 bo 3 hr. 1500 A F/ 37 boph
2 hr. Comp. F/ 736 bopd

Co.
 Lse.
 No.
 Sse.
 F.
 R.