


DX 78-1

Harper KANSAS

Section 23 Township 31 Range 8W

Well No. 1 Thompson

Company Nate Appleman & Trans-Era Petr., Inc.

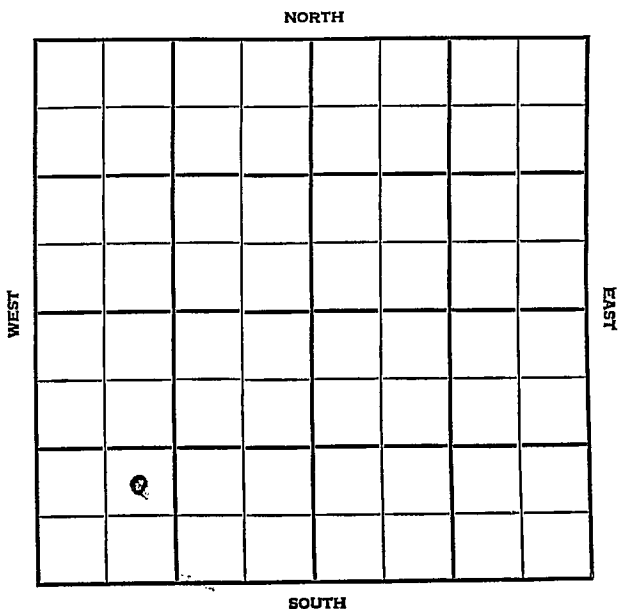

Harper KANSAS

SEC.	TWP.	R.
23	31	8W

WELL NO.

1 Thompson

FARM

COMPANY

Nate Appleman & Trans-Era Petr., Inc.

CONTRACTOR

Trans-Era


Wildcat

_____ Ft. from N. Line

990 _____ Ft. from S. Line

_____ Ft. from E. Line

990 _____ Ft. from W. Line

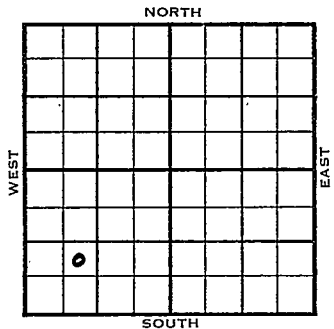

NE SW SW

Stanolind & Sup. DHM - Mag-FO

	ELEVATION	REPORT
1954	1550'	
11/17 12/8	MIR	<p>Spud 11-16-54 D & A TD 4815 8-5/8" @ 205 Heeb 3323 Dodge 3345 Doug 3386 DST 3392-3438 open 1 hr rec 535' SW 1335# Lans 3554 Stal. 3588 KC 3853 Miss 4359' DST 4361-75 open 1 hr gas in 31 min rec 70' GCM 1575# DST 4376-95 open 2 hr rec 630' SW, 320' G & SOCM 1635# Viola 4715 TD 4815 Log tops: Heeb 3312 Tor 3328 B. Oread 3380' Doug. 3394 Lans 3550 Stal. 3585' KC 3844 B KC 4110 Marm 4139 Cherokee 4244 Kh. 4556 Chatt. 4681 Viola 4713 Simp 4753 Miss. 4358' D & A</p>

ABANDONED

