


DX 78-1

Harper KANSAS

Section 23 Township 31 Range 9 W

Well No. # 5 Martin "A"

Company Superior

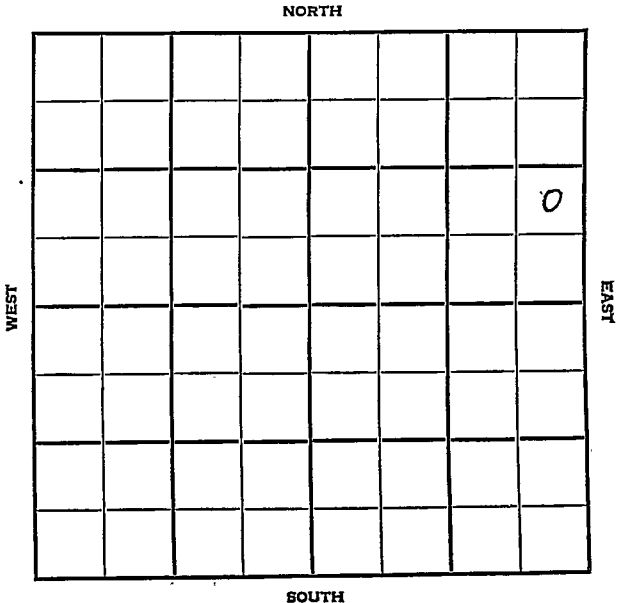

Harper KANSAS

SEC.	TWP.	R.
23	31	9W

WELL NO. 5 Martin "A" FARM

COMPANY Superior


CONTRACTOR Bates & Reading
W. Grabs Pool

_____ Ft. from N. Line

990 _____ Ft. from S. Line

330 _____ Ft. from E. Line

_____ Ft. from W. Line

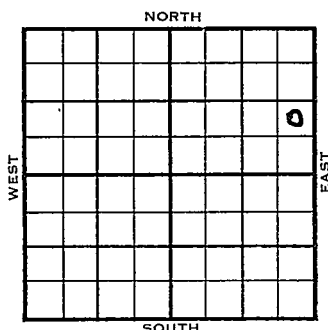

NE SE NE


	ELEVATION	REPORT
1954	1613'	

10/13 Spud 10-10-54
8" @ 300'
Drlg. 497'

12/15 Spud 10-10-54 Oil well TD 4462
8" @ 300 Miss 4385 TD 4462
7" @ 4462 CO 4/4405-06
DST 4485-4400, rec 20' oil 45#
40/4405-10 S/30 BO 3½ hr. S/dry
sd-oilfrac. F/160 BO 24 gr.
F/66 BF 15 hr. 12% wtr. 625#
F/65 BOPD 9% wtr.
Comp. 114 BOPD

COMPLETED

FABEN GILS RAP

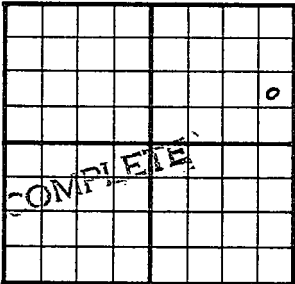County	Harper		State	Kansas	
Sec.	23	(Blk.) Twp.	31	(Sur.) Rge.	9W Map No.
Operator	Superior				
Well No.	5	Farm	Martin "A"		
Elev.	1613	Location	NE SE NE		
			990 Ft. From	S Line	NE
			330 Ft. From	E Line	Quarter
			Ist. Report		
			Completion	DEC 15 1954	
			Remarks	W. Grabs Pool	
			Bates & Reading - Contr.		
			Spudding Date	10-10-54	
Drlg. Data	Oil well		TD 4462		

8" @ 300 Miss. 4385 TD 4462 7" @ 4462
CO 4/ 4405-06 DST 4485-4400 Rec. 20' of
oil 45# 40/ 4405-10 S/ 30 bo 3½ hr.
S/ dry sd-oil-frac F/ 160 bo 24 gr.
F/ 66 bf 15 hr. 12% wtr. 625#
F/ 65 bopd 9% wtr.
Comp. 114 bopd

FABEN GILSTRAP