

Harper

DX 78-1

KANSAS

Section 23 Township 31 Range 9W

Well No. #1 Martin

Company Magnolia Pet.

NORTH

					0		

WEST

EAST

SOUTH

Harper KANSAS

SEC.	TWP.	R.
23	31	9W

WELL NO. **1 Martin** FARM

COMPANY **Magnolia Petr.**

CONTRACTOR **Noble**


Grabs Pool

330 Ft. from N. Line

_____ Ft. from S. Line

_____ Ft. from E. Line

990 Ft. from W. Line

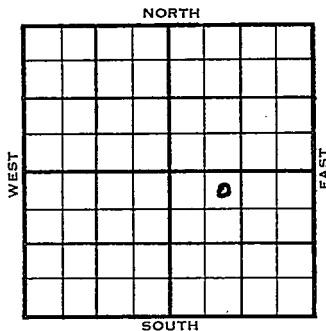

NE NW SE

1955	ELEVATION 1577'	REPORT
------	--------------------	--------

3/2
4/20

Location

Spud 3-5-55 Oil well TD 4480
 8" @ 210 Miss 4354 TD 4480
 4 1/2" @ 4479 CO to 4445 36/4397-4403
 B/15 GO 12 GWPH 7 hr. Visco-frac.
 36/4366-72 B/1 GO 10 BWPH 10 hr.
 Viso-frac P/34 BO 8 BSW 17 hr.
 P/43 BO 13 BSW 24 hrs. P/35 BO
 8 BSW 24 hrs. Comp. 63 BOPD 45 BW

COMPLETED

County Harper State Kansas

Sec. 23 (Blk. 31 (Sur. 9W (Twp. Rge.) Map No.

Operator Magnolia Pet.

Well No. 1 Farm Martin

Elev. 1577 Location NE NW SE

330 Ft. From N Line SE

990 Ft. From W Line Quarter

1st. Report

Completion APR 20 1955

Remarks Grabs Pool

Noble - Contr.

Spudding Date 3-5-55

Drlg. Data Oil well TD 4480

8" @ 210 Miss. 4354 TD 4480

4 1/2" @ 4479 CO to 4445 36/ 4397-4403

B/ 15 go 12 gwph 7 hr. visco-frac

36/ 4366-72 B/ 1 go 10 bwph 10 hr.

visco-frac P/ 34 bo 8 bsw 17 hr.

P/ 43 bo 13 bsw 24 hr. P/ 35 bo

8 bsw 24 hr. Comp. 63 bopd 45 bw

FABEN GILSTRAP