

Harper


KANSAS

SECTION 23 TOWNSHIP 31 RANGE 9 W

WELL NO. #2 Martin

COMPANY Purcell & Mull

NORTH

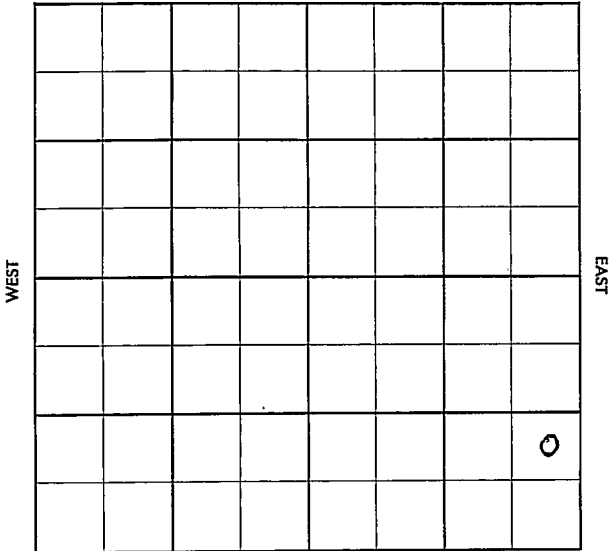

SOUTH

KANSAS

WELL NO.

#2 Martin

FARM

COMPANY

Purcell & Mull

CONTRACTOR

Co. Tools

Grabs


_Ft. from N. Line

Ft. from S. Line

Ft. from E. Line

Ft. from W. Line

NE SE SE

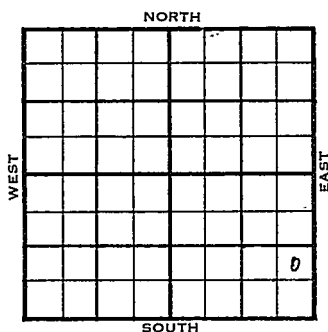

1956

ELEVATION

REPORT

1-18

Comm. 1-14-56

8" @ 160

Dr1g. 1872

County Harper Elev. _____
 Sec. 23 Twp. 31 Rge. 9W
 Company Murcell & Mull
 Farm Name Martin No. 2

TOPS	DEPTH	LOG	DATUM	Loc. in Sec.
Anh.				NE SE SE
Tp.				
H.				
Tr.				
Dg.				
BL.				
L.				Geol.
K.C.				Contr.
B.K.C.				Co. tools
Ce.				
C.				Pool
M.				Grabs
M.				
K.				
Mz.				
Mo.				
V.				
S.				
S.				
A.				
R.				
Pe.				
G.				
T.D.				

FIRST REPORT

JAN 18 1956

Date Comm. 1-14-568" @ 160 drlg. 1872

27

JAN 23 1956

R. G.

County HarperElev. 1565Sec. 23Twp. 31Rge. 9WCompany Purcell & MullFarm Name MartinNo. 2

TOPS	DEPTH	LOG	DATUM	Loc. in Sec.
Asb.				NE SE SE
Tr.				
H.				
Tr.				
Dg.				
Bl.				
L.				
EC				Geol.
BXC				Contr.
Co.				Co. tools
C.				Pool
M.	4349		27TH	Grabs
M.				
K.				
M.				
V.				
S.				
E.				
A.				
R.				
PC				
G.				
TS	4369			

Date Comm. 1-14-56

FEB 15 1956

8" @ 160

drlg. 1872

JAN 25 '56

4180

FEB 1 '56

DST 4351-59 ~~9~~ 1 1/2 hr

900 to S 2" ga 340 MCF in

22" 64 MCF in 45" rec 120'

20CM + 65' 56CM + 25' Mdy

954 SOCW BHP 1440 DST

4359-69 ~~9~~ 2 hr 900 to 555'

rec 60' SOCW + 70' HOCW

+ 15' WTR BHP 1050/20

FEB 27 1956

R. G.

5 1/2 4369 FEB 8 56 CA 42/4355 1/2
- 62 1/2 1/2 FRAO Rec'd F/w
45 Bopd 16/64" ch. FEB 15 56 F/w
Pot 116 Bopd + Tr. w/Tr