

DX 78-1

Harper

KANSAS

Section 23 Township 31 Range 9 W

Well No. # 3 Martin "A"

Company Superior

NORTH

					0		

WEST

EAST

SOUTH

Harper KANSAS


SEC.	TWP.	R.
23	31	9W

WELL NO. 3 Martin "A" FARM

COMPANY Superior

CONTRACTOR Bates & Redding Tools
Grabs Pool

330 Ft. from N. Line
Ft. from S. Line
Ft. from E. Line
990 Ft. from W. Line

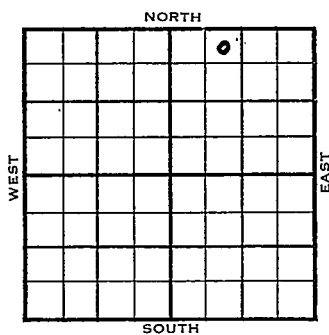

NE NW NE

1954	ELEVATION 1602'	REPORT
9/29	Spud 9-22-54 10" @ 311' w/225 sks Drilg. 2614'	
10/20	Spud 9-22-54 Oil well TD 4491 10" @ 311 Miss 4372 TD 4491 7" @ 4491 4/4379-80 DST 4379-80 open 1 hr gas in 6 min rec 250' oil 1495# 56/4379-86 F/60 BO 10 hr. F/90 BO 19 hr. Comp. 146 BOPD	
	COMPLETED	

FABEN GILSTRAP

County Harper State Kansas
 Sec. 23 (Blk.) 31 (Sur.) 9W Map No.
 Operator Superior Oil
 Well No. 3 Farm Martin "A"
 Elev. 1602 Location NE NW NE

330 Ft. From N Line NE
 990 Ft. From W Line Quarter

1st. Report

Completion OCT 20 1954

Remarks Grabs Pool
Bates & Redding - Contr.

Spudding Date 9-22-54

Drlg. Data Oil well TD 4491
10" @ 311 Miss. 4372 TD 4491
7" @ 4491 4/ 4379-80 DST 4379-80
open 1 hr. gas in 6 min. Rec. 250' oil
1495# 56/ 4379-86 F/ 60 bo 10 hr.
F/ 90 bo 19 hr. Comp. 146 bo/d

FABEN GILSTRAP