
DX 78-1

Harper KANSAS

Section 23 Township 31 Range 9 W

Well No. # 3 Martin "B"

Company Superior Oil

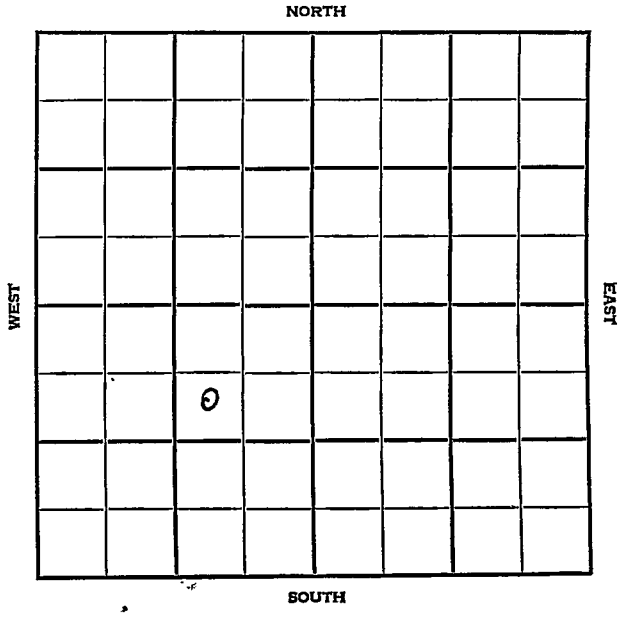

Harper KANSAS

SEC.	TWP.	R.
23	31	9W

WELL NO.

3 Martin "B" FARM

COMPANY

Superior Oil

CONTRACTOR

Reading & Bates

Grabs Pool


990 Ft. from N. Line

_____ Ft. from S. Line

990 Ft. from E. Line

_____ Ft. from W. Line

SW NE SW

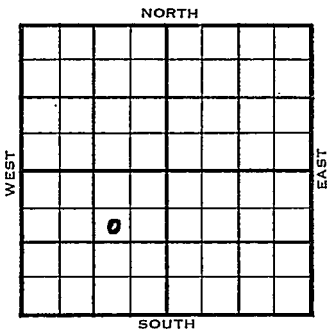

1955	ELEVATION 1633' REPORT
2/9 3/23	MIR Spud 2-6-55, Oil Well, TD 4510 10" @ 318, Miss 4407, TD 4510 7" @ 4510, SP 4490, 56/4420-27 frac R/56 bo 24 hr F/30 BO 20 hr. Comp. F/117 BOPD **COMPLETED**

DX-78

FORM 275 FOR SALE BY KANSAS BLUE PRINT CO.

County Harper State Kansas

Sec. 23 (Blk. Twp.) 31 (Sur. Rge.) 9W Map No.

Operator Superior Oil

Well No. 3 Farm Martin "B"

Elev. Location SW NE SW

FIRST REPORT

990 Ft. From N Line SW

990 Ft. From E Line Quarter

1st. Report FEB 9 1955

Completion

Remarks

Reading & Bates - Contr.

Spudding Date

Drlg. Data Grabs Pool

M I R

FABEN GILSTRAP

FORM 275 FOR SALE BY KANSAS BLUE PRINT CO.


County Harper State Kansas

Sec. 23 (Blk. Twp.) 31 (Sur. Rge.) 9W Map No.

Operator Superior Oil

Well No. 3 Farm Martin "B"

Elev. 1633 Location SW NE SW

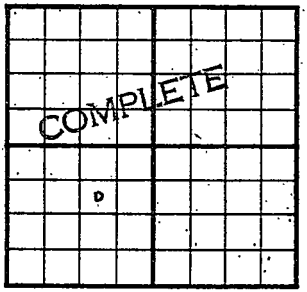

990 Ft. From N Line SW

990 Ft. From E Line Quarter

1st. Report

Completion MAR 2 3 1955

Remarks Grabs Pool

Reading & Bates - Contr.

Spudding Date 2-6-55

Drlg. Data Oil well TD 4510

10" @ 318 Miss. 4407 TD 4510

7" @ 4510 SP 4490 56/ 4420-27

frac F/ 56 bo 24 hr. F/ 30 bo 20 hr.

Comp. F/ 117 bopd.

FABEN GILSTRAP