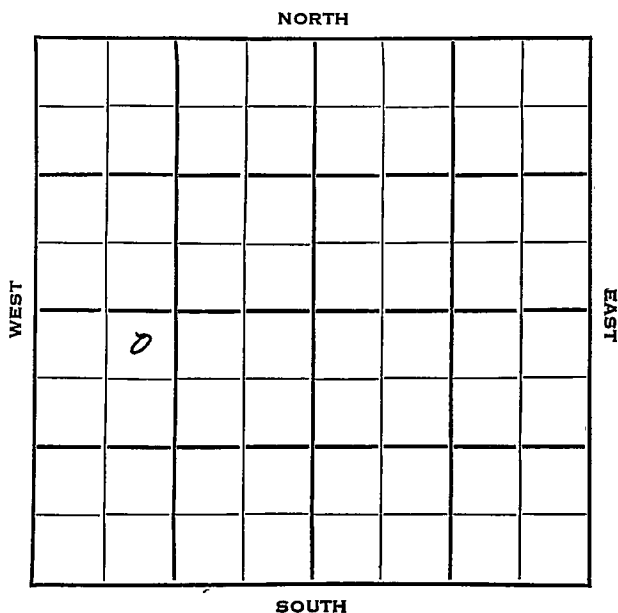



Barber

KANSAS 13W

Section 24 Township 31 Range Well No. #1 Roessler "A"Company Champlin Refining Company

Barber

KANSAS

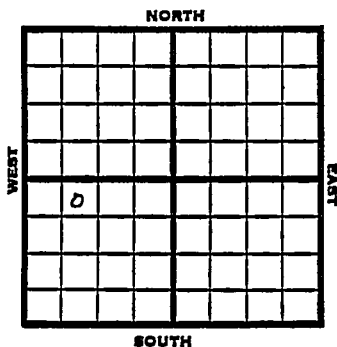Sec. 24 Twp. 31 R. 13WWell No. #1 Roessler "A" FarmChamplin Refining Company Company
Patton Drlg.-Garvie-Gentz Contractor330 Ft. from N. Line Ft. from S. Line Ft. from E. Line990 Ft. from W. Line

NE NW SW

1953 Elev. 1590 REPORT

3/11 Location

3/19 10" @ 198
Drlg. 1875'3/26 Heeb 3499 Doug 3564
DST 3560-78, 1 hr, 25' M 485#
DST 3560-85, 1 hr, 480' SW 1275#
Drilling

4/1 Spud 3-12-53

D & A TD 3950' 10" @ 198

Heeb 3499 Doug. 3564

DST 3560-78 open 1 hr rec 25' mud
485#DST 3560-85 open 1 hr. rec 480' SW
1275#Lans. ~~3766~~ 3696'

TD 3950' D & A

ABANDONED

J. G. McGEHEE

J. G. McGEHEE