

Section 24 Township 31 Range 13WWell No. #1 SmithCompany Champlin Refining Company

NORTH

			0				

WEST

EAST

SOUTH

Barber

KANSAS

Sec. 24 Twp. 31 R. 13WWell No. #1 Smith FarmChamplin Refining Company Company

Contractor


330 Ft. from N. Line

Ft. from S. Line

Ft. from E. Line

330 Ft. from W. Line

NE NE NW

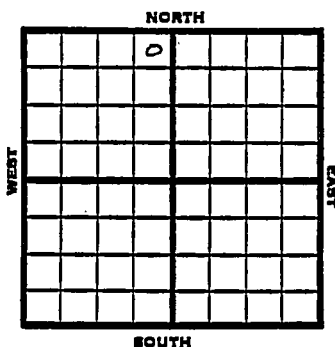

1953	Elev. 1610	REPORT
3/11	Location	
3/19	8" @ 190 Drlg. 1900'	
3/26	Heeb 3503' Doug 3599' DST 3568-3590'	
4/2	NR	
4/9	NR	
4/15	Spud 3-12-53 Gas Well TD 3650' 8" @ 190' Heeb 3503, Doug 3579, DST 3568-3590 open 2 hr. Rec 3,690,000 gas, 30' gcw 1370# DST 3594-3614 open 2 hr. Rec 2850' gassy sw 1395# TD 3650' 7" @ 3649' CO to 3590 17/ 3576-79 5,225,000 gas Comp. shut in gas well	

COMPLETED

County Barber State Kansas
 Sec. 24 (Blk.) 31 (Sur.) 13W Map No.
 Operator Champlin Ref.
 Well No. 1 Farm Smith
 Elev. 1610 Location NE NE NW

			0			

330 Ft. From N Line NW
330 Ft. From E Line Quarter
 1st. Report MAR 11 1953
 Completion _____
 Remarks _____
 Spudding Date _____

Drlg. Data

Location

J. G. McGEHEE

County Barber State Kansas
 Sec. 24 (Blk. 31) (Sur. 13W) (Twp. Map No.)
 Operator Champlin Ref.
 Well No. 1 Farm Smith
 Elev. 1610 Location NE NE NW

			0			

COMPLETE

330 Ft. From N Line NW
330 Ft. From E Line Quarter

1st. Report

Completion APR 15 1953

Remarks

Spudding Date 3-12-53

Drlg. Data Gas well TD 3650

8" @ 190 Heeb. 3503 Doug. 3579

DST 3568-3590 open 2 hr. Rec. 3,690,000

gas 30' gcw 1370# DST 3594-3614

open 2 hr. Rec. 2850' gassy sw 1395#

TD 3650 7" @ 3649 CO to 3590

17/ 3576-79 5,225,000 gas

Comp. shut in gas well

J. G. McGEHEE