

Sec. 24 Twp. 31 R. 37W

Well No. #3 Kenoyer Farm

Republic Natural Gas Company
Hugoton


100 Ft. from N. Line

_____ Ft. from S. Line

100 Ft. from E. Line

_____ Ft. from W. Line

NE SW

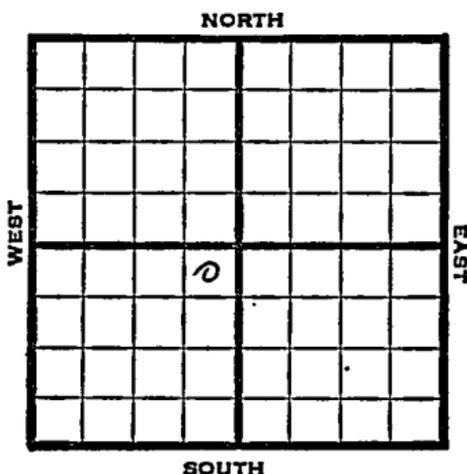

1947

Elev. 3089' REPORT

8/27

Location

9/3

"

9/10

"

9/11

"

9/24

10" @ 544'
TD 2550'
7" @ 2541'
RUST

10/1

"

10/8

TD 2761'
236' of 5" Perf liner @ 2761'

10/15

"

10/22

3,000 acid

10/29

7" @ 2541'
236' of 5" Perf liner
@ 2761'
20,000 acid
25,241,000 Gas
TD 2761'
400# RPr

COMPLETED

Map No. _____ Sec. 24 Twp. 31 R. 37W

Well No. 3 Kenoyer

Republic Natural Gas Company

FIRST REPORT

Contractor

NE SW


SECTION PLAT

100 Ft. from N. Line

_____ Ft. from S. Line

100 Ft. from E. Line

_____ Ft. from W. Line

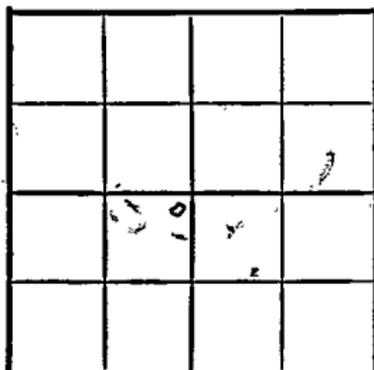

Stevens County

Location X

Rig up _____

Drilling and Remarks:

RECORD

Cased _____ in, _____ ft.

Sand _____

Gas _____

Oil _____

Total Depth _____

PRODUCTION

1st 24 hrs. Nat. _____

1st 24 hrs. after shot _____

Gas _____ Cu. Ft.

Dry Hole _____

Abandoned _____

Date

AUG 27 1947

S. J. LEWIS Scout

Hugoton Pool

Form 26 200 Bks. 10-46 Petrol
Kansas

Map No. 0 Sec. 24 Twp. 31 R. 37W

Well No. 3 Kenoyer

Republic Natural Gas Company

COMPLETE Contractor

NE SW

E12089
SECTION PLAT

100 Ft. from N. Line

_____ Ft. from S. Line

100 Ft. from E. Line

_____ Ft. from W. Line

	△		

Stevens County

Location _____

Rig up _____

Drilling and Remarks:

7" @ 2541
256' of 5" Prof. Unit
@ 2761
25,241,000 lbs
400 R Be*

RECORD

Cased _____ in., _____ ft.

Sand _____

Gas _____

Oil _____

Total Depth 2761

PRODUCTION

1st 24 hrs. Nat. _____

1st 24 hrs. after shot _____

Gas _____ Cu. Ft.

Dry Hole _____

Abandoned _____

Date

OCT 29 1947 19

S. J. LEWIS

Scout