FORM 51 10M 8-47

KANSAS


Seward

Section 24 Township 31 Range 33W

Well No. #1 Eubank

Company Warren Pet.

Hugoton Pool

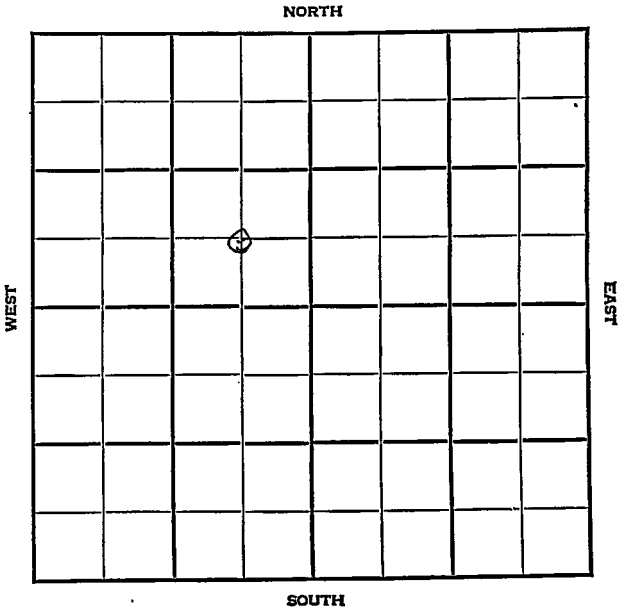

FORM 252-A
5M 12-45 PETROL

KANSAS

Seward County

Sec. 24 Twp. 31 R. 33 W

Well No. #1 Eubank Farm

Warren Pet. Company

Houghton Pool


____ Ft. from N. Line

660 Ft. from S. Line

660 Ft. from E. Line

____ Ft. from W. Line

C SE NW

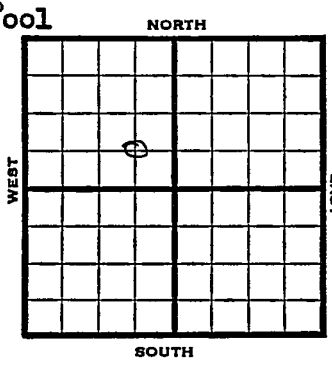

1948	Eli 2876' -- REPORT
4/21	Location
4/28	"
5/4	"
5/12	"
5/19	10" @ 577' Drlg. 2205'
5/26	TD 2622' 7" @ 2620' 3000 acid
6/1	"
6/9	TD 2703'
6/16	96' of 5" Perf liner @ 2703' Total 16,000 acid
6/23	"
6/29	" "
7/14	TD 2703' 7"@ 2620' 96' of 5" Perf Liner @ 2703' 16,000 acid 7,145,000 Gas 420# R Pr. Comp. COMPLETED

Form 26—200 Bks.—1-48—Palace

Hugoton Pool

Kansas

Map No. _____ Sec. 24 Twp. 31 R. 33W


Well No. 1 Eubank

Warren Pet.
Company

FIRST REPORT
Contractor

C SE NW

SECTION PLAT

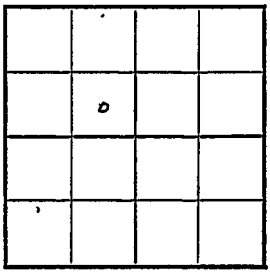

_____ Ft. from N. Line

660 Ft. from S. Line

660 Ft. from E. Line

_____ Ft. from W. Line

Seward County

Location x

Rig up _____

Drilling and Remarks:

RECORD

Cased _____ in., _____ ft.

Sand _____

Gas _____

Oil _____

Total Depth _____

PRODUCTION

1st 24 hrs. Nat. _____

1st 24 hrs. after shot _____

Gas _____ Cu. Ft.

Dry Hole _____

Abandoned _____

Date

APR 21 1948 19 S. J. LEWIS Scout

Form 26—200 Bks.—1-48—Palace

Kansas

Hugoton Pool

Map No. _____ Sec. 24 Twp. 31 R. 33W

Well No. 1 Eubank


Warren Pet. Company

COMPLETE Contractor

C SE NW

El. 2876

SECTION PLAT

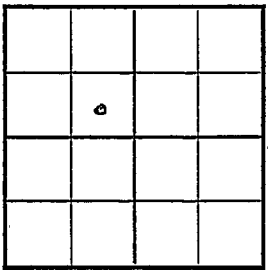

_____ Ft. from N. Line

660 Ft. from S. Line

660 Ft. from E. Line

_____ Ft. from W. Line

Seward ~~Stevens~~ County

Location _____

Rig up _____

Drilling and Remarks:

7" @ 2620

96' of 5" Perf Liner

@ 2703

16 000 and

7,145 000 Gas

420 = RP

RECORD

Cased _____ in., _____ ft.

Sand _____

Gas _____

Oil _____

Total Depth 2703

PRODUCTION

1st 24 hrs. Nat. _____

1st 24 hrs. after shot _____

Gas _____ Cu. Ft.

Dry Hole _____

Abandoned _____

Date

JUL 14 1948 19____

S. J. LEWIS Scout