


KANSAS

FORM 51 5M BRIX

Section 24 Township 31 Range 23W

Well No. 1 Birdsall

Company Phillips

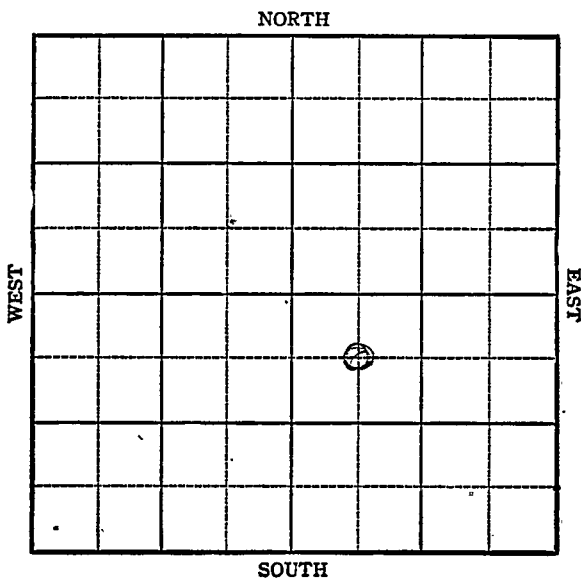

KANSAS

Clark

Sec. 24 Twp. 31 R. 23W

Well No. #1 Birdsall Farm
Phillips Company

Wildcat

660 Ft. from N. Line


Ft. from S. Line

Ft. from E. Line

660 Ft. from W. Line

Elev. 2179

NORTH

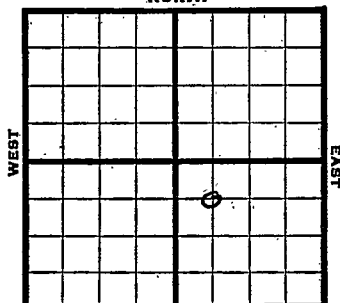

SOUTH

C NW SE

1944

REPORT

8/30 Derrick
9/8 "
9/13 RUR
9/21 "
9/28 #
10/4 "
10/11 Drlg. 675
10/18 Drlg. 1919
10/25 10" @ 2404 WOC

11/1 Fsg.
11/8 Drlg. 3269
11/16 Drlg. 4134
11/24 4755 Drlg.
11/29 4998 fsg.

12/6 " "

12/14 Drlg. 5016'
12/21 Drlg. 5222'
12/29 Drlg. 5510'

1945

1/3 Drlg 5780
1/10 Drlg 6152
1/17 6222 fsg drill pipe
1/26 Drlg. 6255

OVER

1945

1/31 Drlg. 6295'

2/7 Drlg 6432

2/14 Drlg 6732

2/21 Drlg 6877 fsg

2/28 " " "

3/7 " " "


3/14 No tops
TD 6817 tight hole

ABANDONED

KANSAS Pool Name WildcatMap No. 96 Sec. 24 Twp. 31 R. 23WWell No. 1 BirdsellPhillips CompanyFIRST REPORT Contractor

C NW SE

SECTION PLAT

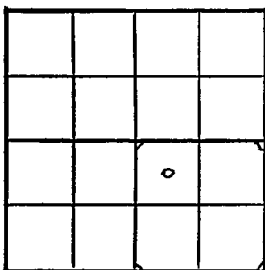660 Ft. from N. Line Ft. from S. Line Ft. from E. Line660 Ft. from W. LineClarkLocation Rig up

Drilling and Remarks:

Derrick

RECORD

Cased in., ft.Sand Gas Oil Total Depth

PRODUCTION

1st 24 hrs. Nat. 1st 24 hrs. after shot Gas Cu. Ft.Dry Hole Abandoned

Date

AUG 30 1944

19

S. J. LEWISScout

Misc. Small Maps	Reid
Cards	Betty
Tracing	ML
France Map	✓
Scarborough Map	Reid
Moody Map	✓
Geological Dept	
Moody Plat Book	

Pool Name WildcatMap No. 96 Sec. 24 Twp. 31 R. 23 WWell No. 1 BirdsallPhillips

Company

ABANDONED

Contractor

C NW SE

SECTION PLAT

660 Ft. from N. Line Ft. from S. Line Ft. from E. Line660 Ft. from W. Line

		6	

ClarkLocation Rig up

Drilling and Remarks:

No tops
tight hole

RECORD

Cased in., ft.Sand Gas Oil Total Depth 6817

PRODUCTION

1st 24 hrs. Nat. 1st 24 hrs. after shot Gas Cu. Ft.Dry Hole Abandoned

Date

MAR 14 1945

19

S. J. LEWIS Scout

Misc. Small Maps	LR
Cards	Petty
Tracing	LR
France Map	✓
Scarborough Map	LR
Pierce Map	✓
Geological Dept.	
Pierce Plat Book	