
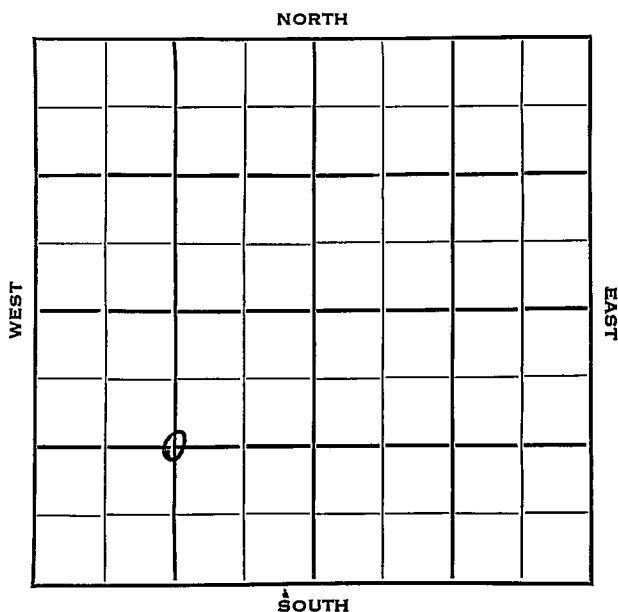


Section 24 Township 31 Range 16 WWell No. # 1 KaminskaCompany Barbara Oil Co.

Sec. 24 Twp. 31 R. 16WWell No. #1 Kaminska FarmBarbara Oil Co. CompanyR.C. Patton Contractor
Robbins Ft. from N. Line1320 Ft. from S. Line Ft. from E. Line1320 Ft. from W. Line

C SW/4

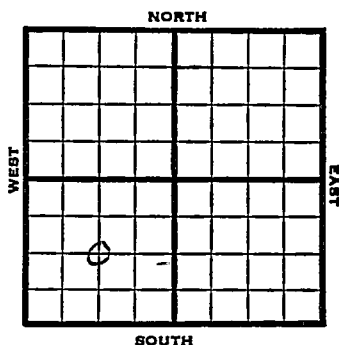

1953 Elev. 2008' REPORT

7/14 Spud 7-14-53

7/22 10" @ 508' w/375 sks
Ft. Riley 2310
Drlg. 2470' $\frac{1}{2}$
7/29 Drlg. 4306'8/5 Heeb 4104, Lans 4290
DST 4771-85 1 hr, 20' socm / 80' mco
DST 4796-4807 1 hr, 8' M Miss 4876
DST 4876-97 1 hr, 20' sgcsm 1665#
202.
DST 4898-4931 1 hr, 25' M
Drlg.8/12 Marm 4871, Miss 4880, V. 5050, Simp
5229, Arb 5328
DST 5222-34 1 hr, 15' M, 1015#
DST 5304-62 1 hr, 20' M, 1380#
RTD 5402 Schl.
5" @ 4959'

8/19 CO 4815 52/ 4770-85 w / sso

8/26 Spud 7-14-53

D & A

TD 5402'

10" @ 508'

Ft. Riley 2310', Heeb 4104', Lans 4290'

OVER

1953

Information brought forward.

8/26 DST 4771'-85' opn 1 hr, rec 20' socm
80' mco
DST 4796'-4807' opn 1 hr, rec 8' mud
0#.
DST 4876'-97' opn 1 hr, rec 20' sgcm
1665#
DST 4898'-4931' opn 1 hr, rec 25' mud
Marm 4871', Miss 4880', Viola 5050',
Simp 5229', Arb 5328'
DST 5322'-34' opn 1 hr, rec 15' mud
1015#
DST 5354'-62' opn 1 hr, rec 20' mud,
1380#
TD 5402'
5" @ 4830'
CO to 4815'
52/ 477-85 wtr. & SO B/ wtr. $\frac{1}{2}$ bo
1100 A
- S/ 55 bsw
D & A

ABANDONED

County Comanche State Kansas
 Sec. 24 (Blk. 31) (Sur. 16W) (Twp. Map No.)
 Operator Barbara Oil
 Well No. 1 Farm Kaminska
 Elev. 2008 Location C SW/4



1320Ft. From S Line SW
1320Ft. From W Line Quarter
 Ist. Report
 Completion AUG 26 1953
 Remarks Robbins Pool
Patton - Contr.
 Spudding Date 7-14-53

Drig. Data D & A TD5402
10" @ 508 Ft. Riley 2310 Heeb. 4104
Lans. 4290 DST 4771-85 open 1 hr.
Rec. 20' socm 80' mco DST 4796-4807
open 1 hr. Rec. 8' mud 0# DST 4876-
97 open 1 hr. Rec. 20' sgcm 1665#
DST 4898-4931 open 1 hr. Rec. 25' mud
Marm. 4871 Miss. 4880 Viola 5050
Simp. 5229 Arb. 5328 DST 5322-34
open 1 hr. Rec. 15' mud 1015#
DST 5354-62 open 1 hr. Rec. 20' mud
1380# TD 5402 5" @ 4830 CO to 4815
52/ 477-85 wtr & SO B/ wtr. 1/2 bo
1100 A S/ 55 bsw


D & A


SEP 1 1953

Scout Cards	
Land Small Map	
Land Vail Map	
Tracings	
France Map	
Pierce Map	
Disc	

Drig Data

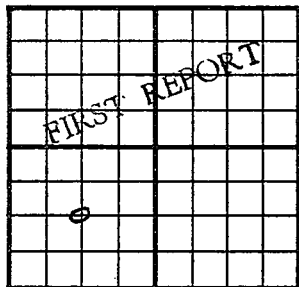County Commanche State KansasSec. 24 (Blk.) 31 (Sur.) 16W Map No.Operator Barbara Oil Co.Well No. 1 Farm KaminskaElev. Location C SW/41320 Ft. From S Line SW1320 Ft. From W Line Quarter1st. Report JUL 14 1953

Completion

Remarks

R.C. Patton - Contr.Spudding Date 7-14-53Drig. Data Robbins

J. G. McGEHEE

JUL 17 1950

Scout Cards	
Lat. & Small Map	
Land Wall Map	
Reading Log	
French Map	
Ice Map	
Test	

Drig. Data