


Harper

KANSAS

SECTION 24 TOWNSHIP 31 RANGE 9W

WELL NO. #4 Darns "B" (*Darnes*)

COMPANY Orville H. Parker

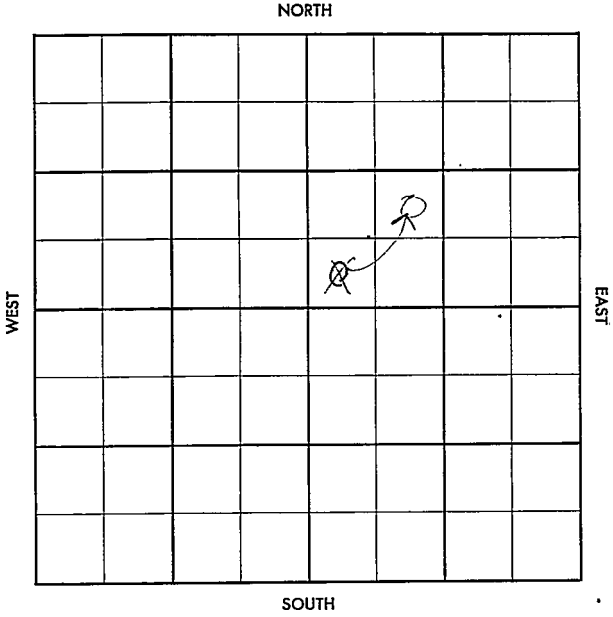

SEC. 24	TWP. 31	R.. 9W
------------	------------	-----------


WELL NO. #4 Darns "B" FARM

COMPANY Orville H. Parker

CONTRACTOR

Grabs

_____ Ft. from N. Line
 _____ Ft. from S. Line
 _____ Ft. from E. Line
 _____ Ft. from W. Line

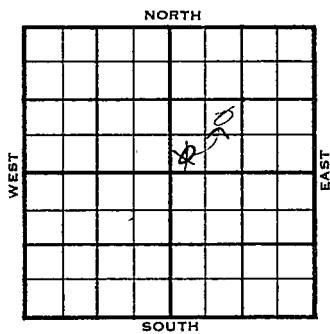

~~SW SW NE~~
 NE SW NE

1956	ELEVATION	REPORT
------	-----------	--------

4-11 Location

County Harper Elev. _____
 Sec. 24 Twp. 31 Rge. 9W
 Company Orville H. Parker
 FarmName Darns "B" No. 4

TOPS	DEPTH	LOG	DATUM	Loc. in Sec.
Anh.				SW SW NE
TP.				
H.				
Tr.				
Dg.				
Bl.				
L.				Geol. _____
K.C.				Contr. _____
B.K.C.				
Ce.				
C.				
M.				
M.				Pool
K.				Grabs
Mz.				
Mo.				
V.				
S.				
S.				
A.				
R.				
PE.				
G.				
T.D.				

FIRST REPORT
 0
 APR 11 1956

Date Comm. _____
 Location _____

APR 17 1956

[Handwritten signature and scribbles]

Co.
Lse.
No.
Sec.
T.
R.

CORRECTION

FORM 513 SUNRAY

County	Harder	Elev.	157
Sec.	21	Twp.	31
Company	Orville H. Harder	Rgs.	9W
Farm Name	Jarns "D"	No.	4

TOPS	DEPTH	LOG	DATUM	Loc. in Sec.
Anh.				NE SW NE
TP.				
H.	3424			
Tr.				
Dg.				
Bl.				
L.	3614			Geol.
K.C.				Contr.
B.K.C.				
Ce.				
C.				
M.	4372			Pool
M.				Grabs
K.				
Mz.				
Me.				
V.				
S.				
S.				
A.				
R.				
PE.				
G.				
TD.	4486			COMPLETE

Date Comm.

Location	APR 13 '55	APR 25 '55	MAY 2 '55
	MAY 9 '55	MAY 16 '55	MAY 23 '55
	MAY 29 '55	JUN 6 '55	
	JUN 13 '55	JUN 20 '55	JUN 27 '55
	JUL 3 '55		
	JUL 11 '55	7-2-56	858 272/250
	ID 2884	ID 3005	JUL 18 '55
	OST 4373-82	1hr. rev. 90'	
	HOCM BHP 650/30"	5 1/2 @	JUL 25 '55
	@ 4486/100	ca 24/4390-96	
	est 30 B0 F 3BW	24 hr.	AUG 1 '55
	AUG 8 '55	SEP 2 '55	

24-31-9.1

meas. of

P. 30 B0 + 40% wt. 24hr

AUG 9 '56

AUG 15 '56

P 3 Bopd +

wt

AUG 22 '56

AUG 29 '56

PB? 8/

4374-76 β Fluid ratio

1 oil to 4 wt 8/4376-78

β 15 to no/w 8/4378-80

β 2004 GF (30% w) 1/2

~~4x4~~ β 3 Bopd ^{25%} w P.P. SEP 5 '56

SEP 12 '56

P. 56 Bopd no/w

P. 38 Bopd no/w

SEP 19 '56

SEP 26 '56

OCT 3 '56

OCT 10 '56

OCT 17 '56

OCT 24 '56

OCT 31 '56 NOV 7 '56

ph P 33

Bopd no/w