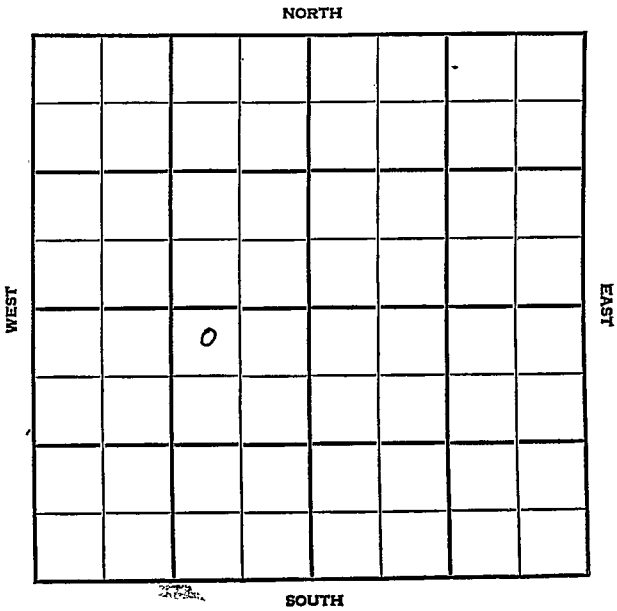


Harper

KANSAS

DX 78-1

Section 24 Township 31 Range 9 WWell No. #1 DarnesCompany Harold Martin

Harper

KANSAS

SEC. 24	TWP. 31	R. 9W
------------	------------	----------

WELL NO.

#1 Darnes

FARM

COMPANY

Harold Martin

CONTRACTOR

Grabs


_____ Ft. from N. Line

_____ Ft. from S. Line

_____ Ft. from E. Line

_____ Ft. from W. Line

NW NE SW

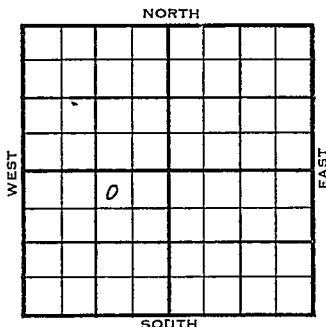

	ELEVATION	REPORT
1955	1616'	
9-14	Location	
12-21	Comm. 9-20-55	
	8 5/8" @ 380	
	DST 4402-09 op 1 1/2 hr. gas in 45 min.	
	rec. 130' o&gcm, 5' mw	
	DST 4402-09 op 1/2 hr. rec. 90' o&ocm	
	1280/60"	
	DST 4409-16 op 1 hr. 10 min. rec 1200'	
	gas 120' ocm, 1620/20"	
	5 1/2" @ 4418	
	CO perf/ 4401-18	
	F/ 50 BOPD, frac F/ 14 bo 1/2 hr.	
	Comp. BHB F/ 211BOPD	
	H. 3447	
	L. 3651	
	M. 4402	
	TD 4418'	
COMPLETED		

County Harper Elev. _____
 Sec. 21 Twp. 31 Rge. 9W
 Company Harold Martin
 Farm Name Darnes No. 1

TOPS

DEPTH

LOG

DATUM

Loc. in Sec.

Anh.

Tp.

H.

Tr.

Dg.

Bl.

L.

K.C.

B.K.C.

Ce.

C.

M.

M.

K.

Mz.

Mq.

V.

S.

S.

A.

R.

PE.

G.

T.D.

NW NE SW

Geol.

Contr.

Pool

Grabs

FIRST REPORT

SEPT 4 '55

Date Comm.

Location

County Harper Elev. 1616
 Sec. 24 Twp. 31 Rge. 9W
 Company Harold Martin
 Farm Name Darnes No. 1

TOPS	DEPTH	LOG	DATUM	Loc. in Sec.
Anh.				NW NE SW
Tp.				
H.	<u>3447</u>		<u>1831</u>	
Tr.				
Dg.				Geol.
Bl.				
L.	<u>3651</u>		<u>2035</u>	
K.C.				
B.K.C.				Contr.
Ce.				
C.				
M.	<u>4402</u>		<u>2786</u>	
M.				Pool
K.				
Mz.				
Ma.				
V.				Grabs
S.				
S.				
A.				
R.				COMPLETE
Pe.				
G.				
T.D.	<u>4418</u>			

Date Comm. 9-20-55 DEC 21 1955
8 5/8" @ 380 DST 4402-09 open 1 1/2 hr.
gas in 45 min. rec. 130' o & ocm 5' mw
DST 4402-09 open 1/2 hr. rec. 90' o & ocm
1280/60" DST 4409-16 open 1 hr. 10 min.
rec. 1200' gas 120' ocm 1620/20"
5 1/2" @ 4418 CO perf/ 4401-18
F/ 50 bopd frac F/ 14 bo 1/2 hr.
Comp. BHB F/ 211 bopd