


Harper

KANSAS

SECTION 24 TOWNSHIP 31 RANGE 9 W

WELL NO. #3 Darnes

COMPANY O. H. Parker

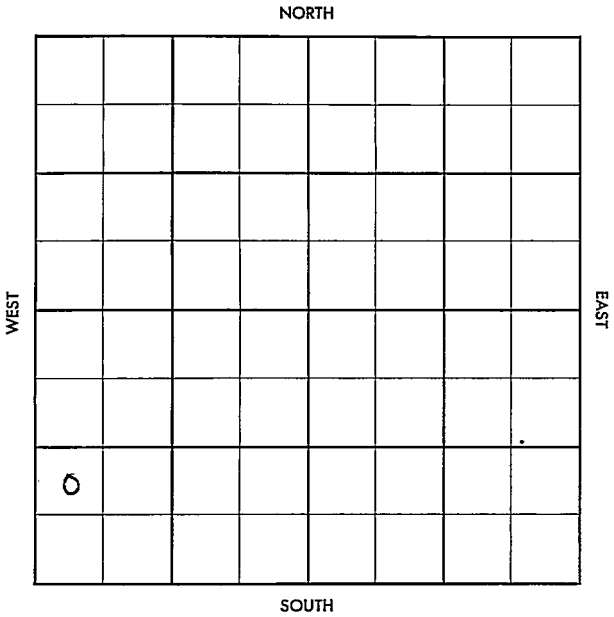





County Harper Elev. 1579  
 Sec. 24 Twp. 31 Rge. 9W  
 Company O. H. Parker  
 Farm Name Darnes No. 3

TOPS	DEPTH	LOG	DATUM	Loc. in Sec.																					
Anh.				NW SW SW																					
TP.																									
H.	<u>3419</u>		<u>1840</u>																						
Tr.																									
Dg.																									
Bl.																									
L.	<u>3613</u>		<u>2034</u>	Geol.																					
K.C.				Contr.																					
B.K.C.				<u>Gabbert-Jones</u>																					
Ce.				Pool																					
C.				<u>Grabs</u>																					
M.	<u>4365</u>		<u>2786</u>	<table border="1"> <tr><td></td><td></td><td></td></tr> <tr><td></td><td></td><td></td></tr> <tr><td></td><td></td><td></td></tr> <tr><td></td><td></td><td></td></tr> <tr><td></td><td></td><td></td></tr> <tr><td></td><td></td><td></td></tr> <tr><td></td><td></td><td></td></tr> </table>																					
M.																									
K.																									
Mz.																									
Mq.																									
V.																									
S.																									
S.																									
A.																									
R.																									
PE.																									
G.																									
T.D.	<u>4462</u>																								

Date Comm. 11-24-55 JAN 11 1956

8 5/8" @ 298/300 DST 4366-82 open

1 hr. gas in 20 min. rec. 135' o &

gcm 50' muddy gassy oil 1540/20"

5 1/2" @ 4458/150 CO to 4423 28/ 4374-81

FU 600' oil 12 hr. Comp. 30 bopd