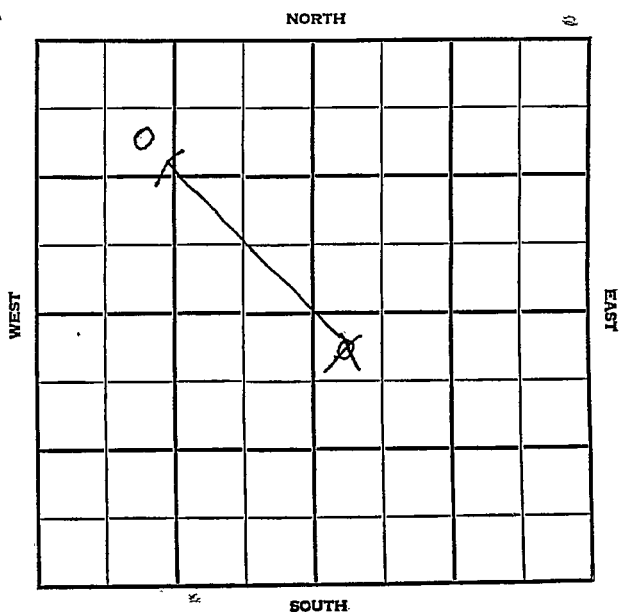


Section 24 Township 31 S Range 9 WWell No. #1 Darnes RanchCompany Stanolind Oil And Gas

Harper

KANSAS

SEC.	TWP.	R.
24	31S	9W

WELL NO.

#4 Darnes Ranch

FARM

COMPANY

Stanolind Oil & Gas

CONTRACTOR

Noble

Grabs

990 Ft. from N. Line


Ft. from S. Line

Ft. from E. Line

990 Ft. from W. Line

~~N W NW SE~~

SE NW NW

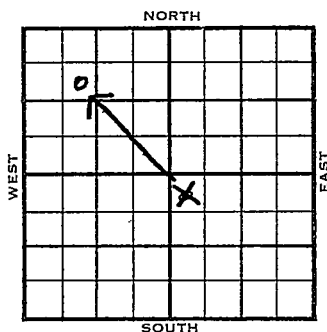

1955

ELEVATION
1615'

REPORT

9/28

Loc

11-30

Comm. 9-29-55

8 5/8" @ 216/250

DST 4386-4415 op 1 hr. gas in 2 min.,
 1250 mcfg in 7 min., oil to surface in
 42 min. rec. 462' oil, 60' ocm, 20'
 ocwm 1458/30"

5 1/2" @ 4499/200

CO to 4482 24/ 4420-26, 6 go, 1 gswph
 2 hrs. 500 A,

F/ 10 BOPH

Comp. 264 BOPD, 4% wtr.

L. 3637

M. 4386

TD 4500'

COMPLETED

Elev.

Company Stanolind Oil & Gas

FarmName Darnes Ranch No. 11

Co.

DEPTH

LOG

DATIIM

Loc. in Sec.

Anh.

T.P.

H.

Te...

Dg.

B.L.

L. —

K.C.

B.K.C.

Ce.

C. —

M. —

M. —

K. —

Mz.

Ma.

V. —

\$. —

S. —

A —

R. —

Pt. _____

G. —

—

Geol.

Contr

Noble

Pool

Grabs

FIRST REPORT

Date Comm.

SEP 28 1955

Loc.

Use

No.

585

7

५

SCOUT TICKET

DX-201

SEC.

TWP.

R.

24

31

9W

WELL NO.

1 Darnes Ranch

FARM

COMPANY

Stanolind

CONTRACTOR

CORRECTION


SE NW NW

990 FT. FROM N. LINE

FT. FROM S. LINE

FT. FORM E. LINE

990 FT. FROM W. LINE

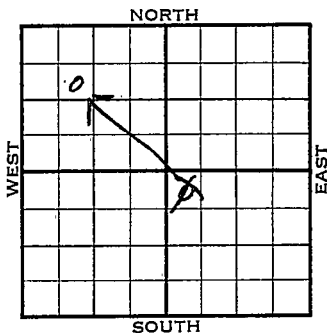

Harper County

☐ LOCATION☐ RIG UP

DRILLING AND REMARKS:

Reported

NW NW SE

RECORD

CASED IN., FT.

SAND

GAS

OIL

TOTAL DEPTH

1ST 24 HRS. NAT.

1ST 24 HRS. AFTER SHOT

GAS CU. FT.

DRY HOLE

ABANDONED

PRODUCTION

DATE

SEP 28 1955

SCOUT

L. J. Harris

SCOUT TICKET

DX-201

SEC.

24

TWP.

31

R.

9W

WELL NO.

1 Darnes Ranch

FARM

COMPANY

Stanolind

CONTRACTOR

CORRECTION

SE NW NW


990 FT. FROM N. LINE

FT. FROM S. LINE

FT. FORM E. LINE

990

FT. FROM W. LINE

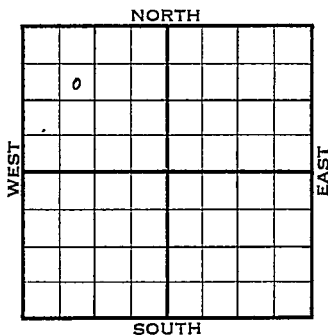

Harper County

☐ LOCATION ☐ RIG UP DRILLING AND REMARKS: Reported NW NW SE	RECORD	CASED	IN.,	FT.
		SAND		
	PRODUCTION	GAS		
		OIL		
		TOTAL DEPTH		
		1ST 24 HRS. NAT.		
		1ST 24 HRS. AFTER SHOT		
		GAS	CU. FT.	
DRY HOLE				
ABANDONED				

DATE

NOV 30 1955

SCOUT

County Harper Elev. 1615
 Sec. 24 Twp. 31 Rge. 9W
 Company Stanolind
 Farm Name Darnes Ranch No. 11

TOPS	DEPTH	LOG	DATUM	Loc. in Sec.
Anh.				SE NW NW
TP.				
H.				
Tr.				
Dg.				
BL.				
L.	3637		2022	Geol.
K.C.				Contr.
B.K.C.				Noble
Ce.				
C.	4386		2771	Pool
M.				Grabs
M.				
K.				
Mz.				
Mq.				
V.				
S.				
S.				
A.				
R.				
PE.				
G.				
TD.	4500			

Date Comm. 9-29-55 NOV 30 1955
8 5/8" @ 216/250 DST 4386-4415
open 1 hr. gas in 2 min. 1,250 mcfg
in 7 min. oil to surface in 42 min.
rec. 462' oil 60' ocm 20' ocwm
1458/30" 5 1/2" @ 4499/200 CO to 4482
24/ 4420-26 6 go 1 gswph 2 hr.
500 A F/ 10 boph Comp. 264 bopd 4% wtr