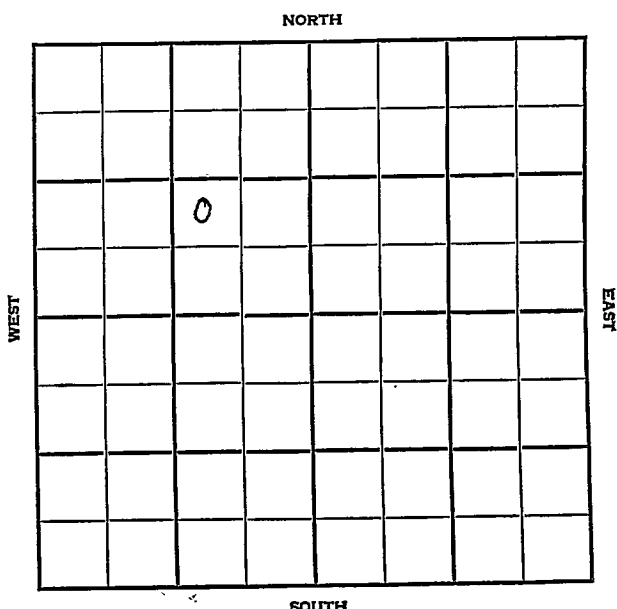


Section 24 Township 31 Range 9 WWell No. #5 Darnes RanchCompany Stanolind

Harper

KANSAS

SEC.	TWP.	R.
24	31	9W

WELL NO.

#5 Darnes Ranch

FARM

COMPANY

Stanolind

CONTRACTOR

Noble

Grabs Pool


_____ Ft. from N. Line

_____ Ft. from S. Line

_____ Ft. from E. Line

_____ Ft. from W. Line

NW SE NW

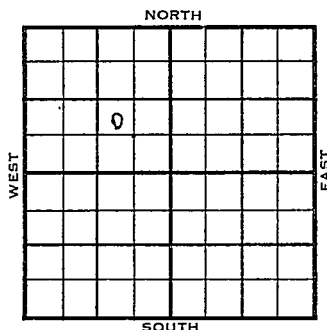

1956

ELEVATION

1632

REPORT

2-15 Location

3/28

Comm 2-23-56 "

L 3650

M 4404

TD 4500

8 5/8" @ 205/250 5 1/2" @ 4499/200

CO to 4481 40/4432/42 S/2 boph

500 A S/4 boph 6 hr frac

S/4 bo 12 bwph 8 hr CO 24/4430-36

1 boph 4 hr 500 A S/5 3/4 boph

Comp F 142 bopd 2% wtr

COMPLETED

County Harper Elev. _____
 Sec. 24 Twp. 31 Rge. 9W
 Company Stanolind
 Farm Name Darnes Ranch No. 5

TOPS	DEPTH	LOG	DATUM	Loc. in Sec.
Anh.				NW SE NW
Tr.				
Dg.				
Bl.				
L.				
K.C.				Geol.
B.K.C.				Contr.
Ce.				Noble
C.				
M.				Pool
M.				Grabs Pool
K.				
Mz.				
Mq.				
V.				
S.				
S.				
A				
R.				
Pe.				
G.				
T.D.				

Date Comm.

Location

Co.

Loc.

No.

Sec.

T.

R.

County Harper Elev. 1632
 Sec. 21 Twp. 31 Rge. 9W
 Company Stanolind
 Farm Name Darnes Ranch No. 5

TOPS	DEPTH	LOG	DATUM	Loc. in Sec.
App.				NW SE NW
TP.				
H.				
Tr.				
Dg.				
BL.				
L.	3650		2018	Geol.
K.C.				Contr.
B.K.C.				Noble
Ce.				Pool
C.				Grabs
M.	4404		2772	
M.				
K.				
Mz.				
Mq.				
V.				
S.				
S.				
A.				
R.				
PE.				
G.				
T.D.	4500			

MAR 28 '56	
0	
COMPLETE	

Date Comm. 2-23-56

8 5/8" @ 205/250 5 1/2" @ 4499/200

CO to 4481 40/ 4432-42 S/ 2 boph

500 A S/ 4 boph 6 hr. frac

S/ 4 bo 12 bwph 8 hr. CO 24/ 4430-36

1 boph 4 hr. 500 A S/ 5 3/4 boph

Comp. F. 142 bopd 2% wtr.