

Harper KANSAS

Well No. # 1 M. G. Ison

Company Stanolind

[illegible]

SOUTH

Harper KANSAS

SEC.	TWP.	R.
24	31	9W

WELL NO.

1 M. G. Ison

FARM

COMPANY

Stanolind

CONTRACTOR

Barbour

W. Grabs Pool


330 Ft. from N. Line

Ft. from S. Line

Ft. from E. Line

330 Ft. from W. Line

NW NW NW

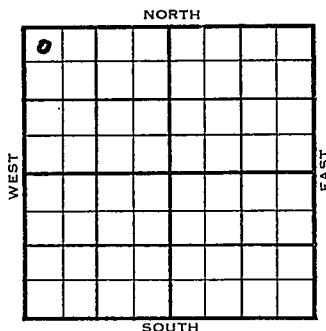

1954

ELEVATION,

1626'

REPORT

10/13

MIR

11/23

Spud 10-12-54

Oil Well

TD 4500'

8" @ 197'

Lans 3637' Miss 4382'

DST 4380'-4410' opn 1 hr, 1,150,000 cfb

15' gco 150' free oil 1563#

DST 4405'-40' opn 1 hr, gas to surface
in 4 min, oil in 48 min, 1000#

Rec 2860' free oil 1650#

DST 4442'-88' opn 1 hr, rec 270' o &
gcm 200' o & gcw. 600' s.w. 1640#

TD 4500'

5" @ 4489'

CO to 4471'

48/ 4408-18 S/ 2 1/2 boph 10 hr.

Sd-oil-frac. F/ 20 boph

Comp F/ 484 bopd.

COMPLETED

County Harper State KansasSec. 24 (Blk.) 31 (Sur.) 9W Map No.Operator StanolindWell No. 1 Farm M. G. IsonElev. Location NW NW NW

0						

FIRST REPORT

330 Ft. From N Line NW330 Ft. From W Line Quarter1st. Report OCT 13 1954

Completion


Remarks

Barbour - Contr.

Spudding Date

Drlg. Data W. Grabs PoolM I R

FABEN GILSTRAP

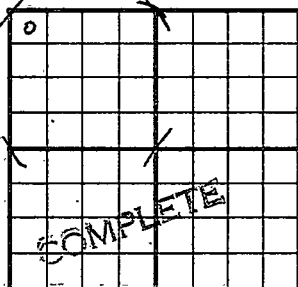County Harper State KansasSec. 24 (Blk. 31 (Sur. 9W Map No.)
(Twp.) (Rge.)Operator StanolindWell No. 1 Farm M. G. IsonElev. 1626 Location NW NW NW330 Ft. From N Line NW330 Ft. From W Line Quarter1st. Report Completion NOV 23 1954Remarks W. Grabs PoolBarbour - Contr.Spudding Date 10-12-54Drilg. Data Oil well TD 45008" @ 197 Lans. 3637 Miss. 4382DST 4380-4410 open 1 hr. 1,150,000 cfg15' gco 150' free oil 1563#DST 4405-40 open 1 hr. gas to surfacein 4 min. oil in 48 min. 1000#Rec. 2860' free oil 1650# DST 4442-88open 1 hr. Rec. 270' o & gcm 200' o &gcw 600' sw 1640# TD 45005" @ 4489 CO to 4471 48/ 4408-18S/ 2½ boph 10 hr. sd-oil-fracF/ 20 boph Comp. F/ 48½ bopd.

FABEN GILGIR