

Section 24 Township 31 Range 9 W
Well No. # 2 M. G. Ison
Company Stanolind

NORTH

0							

WEST

EAST

SOUTH

KANSAS

SEC.	TWP.	R.
24	31	9 W

WELL NO.

2 M. G. Ison

FARM

COMPANY

Stanolind

CONTRACTOR

Barbour

W. Grabs Pool

Ft. from N. Line

990

Ft. from S. Line


Ft. from E. Line

330

Ft. from W. Line

NW SW NW

NORTH

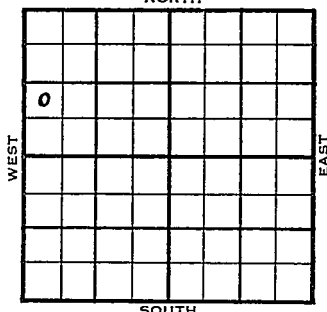

SOUTH

1954

ELEVATION

1603'

REPORT

12/22

Spud 12-17-54

8th @ 198

Drlg. 199'

1955
2/9

Spud 12-17-54 Oil well TD 4500
8" @ 198 Lans 3627 Miss 4375

DST 4375-4400 open 1 hr gas in 4 min
434,000 CFG 75' O & GCM, 120' oil,
60' MGCO 1500#

DST 4400-30 open 1 hr. rec 330' oil
60' MGCO, 105' O & GCM, 60' SW 1445#

DST 4430-60 open 1 hr., rec 150'

O. & GCM, 780# TD 4500

5" @ 4499 CO to 4476 40/4414-24


500 A S/3 $\frac{1}{2}$ BOPH 12 hr. sd-oil-frac.
F/12 BOPH 7 BW

Comp. F/258 BOPD 30% w tr.

COMPLETED

FARRE GILSTRAP

County Harper State Kansas
 Sec. 24 (Blk.) 31 (Sur.) 9W Map No.
 Operator Stanolind
 Well No. 2 Farm M. G. Ison
 Elev. 1603 Location NW SW NW

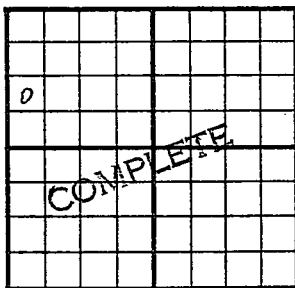

990 Ft. From S Line NW
330 Ft. From W Line Quarter
 Ist. Report FEB 9 1955
 Completion
 Remarks W. Grabs Pool
Barbour - Contr.
 Spudding Date 12-17-54

Drlg. Data Oil well TD 4500
8" @ 198 Lans. 3627 Miss. 4375
DST 4375-4400 open 1 hr. gas in 4 min.
434,000 cfg 75' o & gcm 120' oil
60' mgco 1500# DST 4400-30 open 1 hr.
Rec. 330' oil 60' mgco 105' o & gcm
60' sw 1445# DST 4430-60 open 1 hr.
Rec. 150' o & gcm. 780# TD 4500
5" @ 4499 CO to 4476 40/ 4414-24
500 A S/ 3 $\frac{1}{2}$ boph 12 hr. sd-oil-frac
F/ 12 boph 7 bw
Comp. F/ 258 bopd 30% wtr.

FABEN GILSTRA