

Harper KANSAS

Section 24 Township 31 Range 9 W
Well No. # 3 M. G. Ison
Company S Stanolind

WEST

EAST

SOUTH

Harper

KANSAS

SEC.	TWP.	R.
24	31	9 W

WELL NO.

3 M. G., Ison

FARM

COMPANY

Stanolind

CONTRACTOR

Barbour

W. Grabs Pool


330 Ft. from N. Line

Ft. from S. Line

990 Ft. from E. Line

Ft. from W. Line

NW NE NW

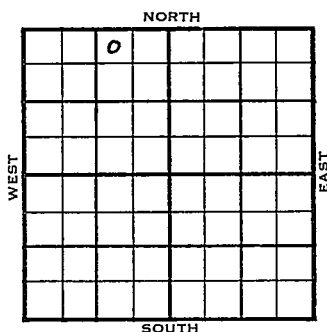

	ELEVATION	REPORT
1954	1626'	
12/22	Location	
1955 2/23	Spud 1-8-55 Oil well TD 4500 8" @ 199 DST 4380-4405 open $\frac{1}{2}$ hr gas in 1 min, 6,640,000 CFG, rec 35' MCO 1570# DST 4405-35 open 1 hr, gas in 4 min rec 1470' gassy oil, 15' SW 615# TD 4500 5" @ 4499 CO to 4470 16/4416-20 500 A 4 BOPH sd-oil-frac F/20 BOPH 10% wtr. 6 hr. Lans 3637 Miss 4382' Comp. 1296- BOPD 15%wtr	
	COMPLETED	

County Harper State KansasSec. 24 (Blk. Twp.) 31 (Sur. Rge.) 9W Map No.Operator StanolindWell No. 3 Farm M. G. IsonElev. Location NW NE NW

		0			

330 Ft. From N Line NW990 Ft. From E Line Quarter1st. Report DEC 22 1954

Completion

Remarks

Barbour - Contr.

Spudding Date

Drilg. Data W. Grabs PoolLocation

FABEN GILSTRAP

County Harper State Kansas

Sec. 24 (Blk. Twp.) 31 (Sur. Rge.) 9W Map No.

Operator Stanolind

Well No. 3 Farm M. G. Ison

Elev.	1626	Location	NW NE NW
-------	------	----------	----------

0

COMPLETE

330 Ft. From N Line NW c

990 Ft. From E Line Quarter

1st. Report

Completion FEB 23 1955

Remarks W. Grabs Pool

Barbour - Contr.

Spudding Date 1-8-55

Drig. Data Oil well TD 4500

8" @ 199 ~~1115-4380~~ DST 4380-4405

open $\frac{1}{2}$ hr. gas in 1 min. 6,640,000 cfm

Rec. 35' mco 1570# DST4405-35 open 1 h

gas in 4 min. Rec. 1470' gassy oil

15' SW 615# TD 4500 5" @ 4499

CO to 4470 16/ 4416-20 500 A

4 boph sd-oil-frac F/ 20 boph 10% wtr

6 hr. Lans. 3637 Miss. 4382

Comp. 1296 bord 15% wtr.

FABEN GILSTRAP