


Harper

KANSAS

SECTION 25 TOWNSHIP 31 RANGE 9 W

WELL NO. #2 E. M. Broce

COMPANY Carter Oil

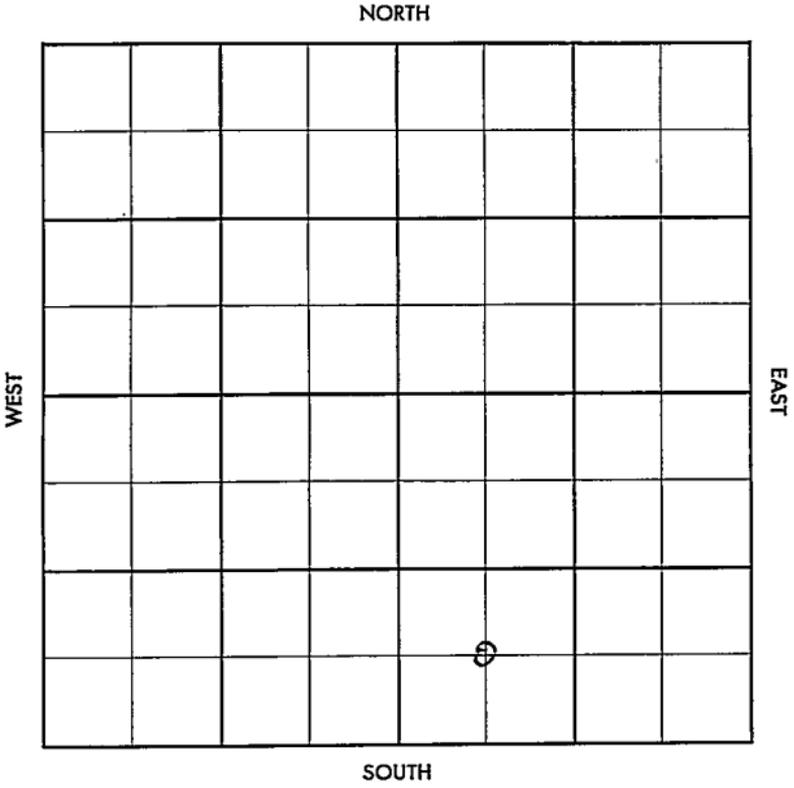

SEC.	TWP.	R.
25	31	9W

WELL NO. #2 E. M. Broce FARM

COMPANY Carter Oil

CONTRACTOR Garvey  
Grabs Pool


\_\_\_\_\_ Ft. from N. Line

495' \_\_\_\_\_ Ft. from S. Line

\_\_\_\_\_ Ft. from E. Line

330' \_\_\_\_\_ Ft. from W. Line

C SW SE

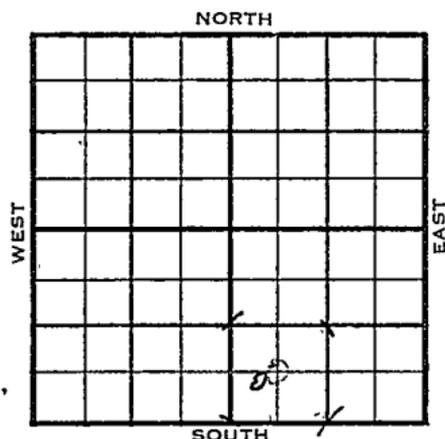

1955	ELEVATION 1549'	REPORT
------	--------------------	--------

11/2 Loc

12-28 Comm. 11-2-55  
 8 5/8" @ 223/200  
 DST 4353-63 op 1 hr. rec. 60' gcm, 60'  
 ho&gcm, 1405/30"  
 DST 4364-72 op 1 hr. gas in 6 min.,  
 84 mcfg dec. to 0 in 20 Min. rec. 210'  
 oil, 360' g&ocm, 1620/30"  
 5 1/2" @ 4361/200  
 CO to 4373  
 S/ 5 boph, frac  
 F/ 463 bo 11 hrs.  
 Comp. BHB F/ 3000 BOPD

H.	3372	3374
Tr.	3409	3406
L.	3608	3608
KC	3878	3888
BKC	4142	4140
M.	4350	4348

TD 4370

COMPLETED

V

County Harper Elev. \_\_\_\_\_

Sec. 25 Twp. 31 Rge. 9W

Company Carter Oil

Farm Name E. M/ Broce No. 2

TOPS	DEPTH	LOG	DATUM
Anh.			
Tr.			
Dg.			
Bl.			
L.			
K.C.			
B.K.C.			
Ce.			
C.			
M.			
M.			
K.			
Mz.			
Me.			
V.			
S.			
S.			
A.			
R.			
PE.			
G.			
T.D.			

Loc. in Sec. C SW SE

495' SL

330' WL

Geol. \_\_\_\_\_

Contr. Garvey

Pool Grabs Pool

FIRST REPORT	
NOV	2 '55
o	

Date Comm. \_\_\_\_\_

Location \_\_\_\_\_

\_\_\_\_\_

\_\_\_\_\_

Co.

Loc.

No.

Sec.

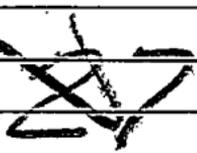

County Harper Elev. 1549  
 Sec. 25 A 31 Rge. 9W  
 Company Carter Oil  
 FarmName E. M. Broce No. 2

TOPS	DEPTH	LOG	DATUM	Loc. in Sec.																														
Anh.				C SW SE																														
TP.																																		
H.	3372	3374	1825	495' SL																														
Tr.	3409	3406	1857	330' WL																														
Dg.																																		
BL.																																		
L.	3608	3608	2159	Geol.																														
K.C.	3878	3888	2339																															
B.K.C.	4142	4140	2591	Contr.																														
Ce.																																		
C.				Garvey																														
M.	4350	4348	2799	Pool																														
M.																																		
K.				Grabs																														
Mz.																																		
Mo.				<table border="1"> <tr><td></td><td></td><td></td></tr> </table>																														
V.																																		
S.																																		
S.																																		
A																																		
R.																																		
PE.																																		
G.																																		
T.D.	4370																																	

Date Comm. 11-2-55 DEC 28 1955  
8 5/8" @ 223/200 DST 4353-63 open 1 hr  
rec. 60' gcm 60' ho & gcm 1405/30"  
DST 4364-72 open 1 hr. gas in 6 min.  
8 1/2 mcfg dec. to 0 in 20 min. rec.  
210' oil 360' g & ocm 1620/30"  
5 1/2" @ 4361/200 GO to 4373 S/ 5 boph  
frac F/ 463 bo 11 hr.  
Comp. BHB F/ 3000 bopd