


DX 78-1

Section 25 Township 31 Range 9W
 Well No. 1 E. M. Broce
 Company Carter Oil

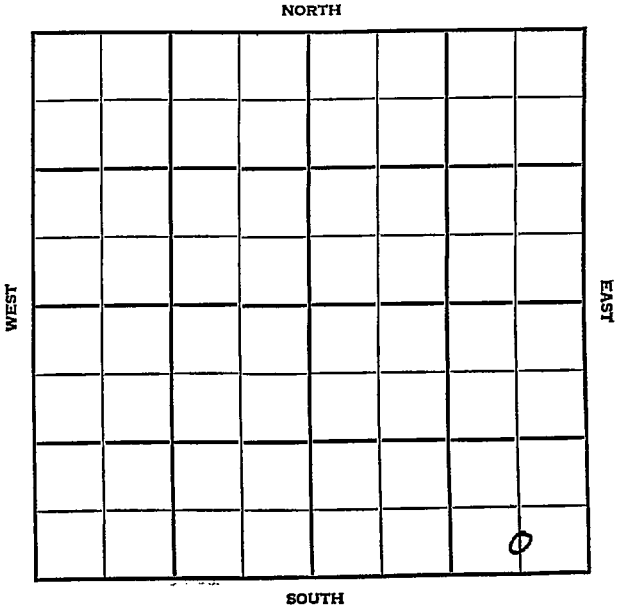

Harper KANSAS

SEC.	TWP.	R.
25	31	9W

WELL NO.

1 E.M. Broce

FARM

COMPANY

Carter Oil

CONTRACTOR

Adkins


S. Grabs Pool

Ft. from N. Line

330 Ft. from S. Line

660 Ft. from E. Line

Ft. from W. Line

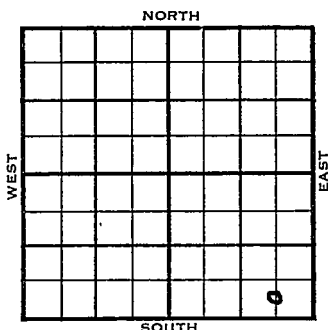

C S/2 SE SE

	ELEVATION	REPORT
1954	1559'	

7/14 Spud 7-10-54
8" @ 213', WOC

7/21 Drlg. 3347

9/22 Spud 7-10-54 - Oil Well

TD 4389'

8" @ 213'

ans 3651', Miss 4368'

DST 4370-74', opn 1½ hrs., rec. 15'

sgcm, 550#

DST 4375-80', opn 1½ hrs., rec. 70'

OCM, 695#

DST 4381-88', 300,000 cfg oil in 35",

TD 4389'


5" @ 4380'

CO to 4388'

F/96 bopd

Comp. F/57 bopd

COMPLETED

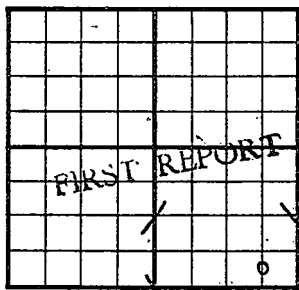
County Harper State KansasSec. 25 (Blk. Twp.) 31 (Sur. Rge.) 9W Map No.Operator Carter OilWell No. 1 Farm E. M. BroceElev. Location C S $\frac{1}{2}$ SE SE330 Ft. From S Line SE660 Ft. From E Line Quarter1st. Report JUL 14 1954

Completion

Remarks.

Adkins - Contr.Spudding Date 7-10-54Drlg. Data S. Grabs Pool8" @ 213 WOC

J. G. McGEHEE

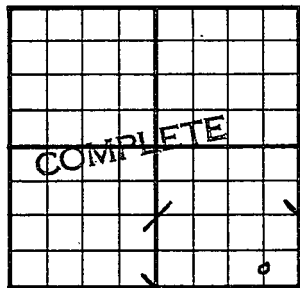County Harper State KansasSec. 25 (Blk. Twp.) 31 (Sur. Rge.) 9W Map No.Operator Carter OilWell No. 1 Farm E. M. BroceElev. 1559 Location C S $\frac{1}{2}$ SE SE330 Ft. From S Line SE660 Ft. From E Line Quarter1st. Report Jul 14 1954Completion SEP 22 1954

Remarks

Adkins - Contr.Spudding Date 7-10-54Drlg. Data Oil well TD 4389 S. Grabs Pool8" @ 213 Lans. 3651 Miss. 4368DST 4370-74 open 1 $\frac{1}{2}$ hr. Rec. 15' sgcm550# DST 4375-80 open 1 $\frac{1}{2}$ hr. Rec. 70'ocm 695# DST 4381-88 300,000 cfgoil in 35 min. TD 4389 5" @ 4380CO to 4388 F/ 96 bopdComp. F/ 57 bopd

FABEN GILSTRAP