

DX 78-1


Stevens

KANSAS

Section 25 Township 31 Range 35 W

Well No. # 1 Lowe

Company Northern Natural

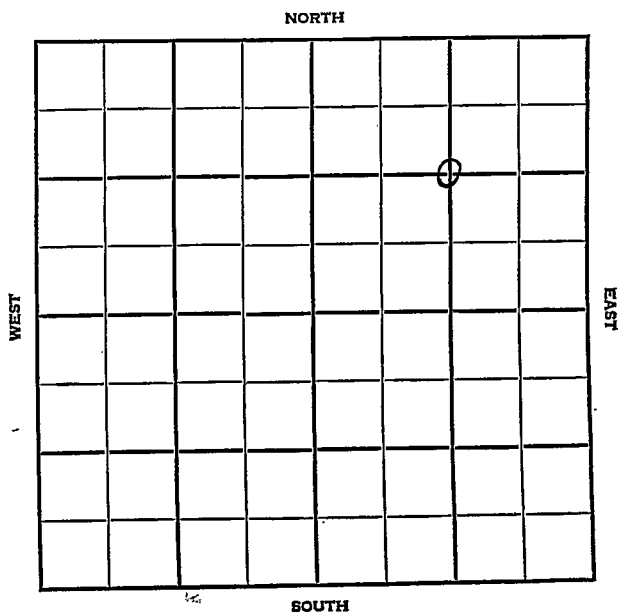

SEC. 25	TWP. 31	R. 35W
------------	------------	-----------

WELL NO. #1 Lowe FARM

COMPANY Northern Natural

CONTRACTOR Moran

Hugoton Pool


1320 Ft. from N. Line

Ft. from S. Line

1320 Ft. from E. Line

Ft. from W. Line

C NE/4

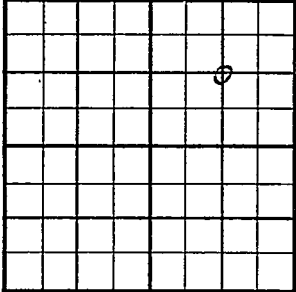

1954	ELEVATION 2917'	2924'	REPORT
------	--------------------	-------	--------

11/23 Location

12/29 Spud 11-20-54 Gas well TD 2680
 10" @ 550' er 2550' Kri. 2612
 Win. 2654 TD 2680 7" @ 2553
 20,000 A
 Comp. 22,366,000 CFGPD 385#

COMPLETED

